

WATER SERVICE RECORD

Name **Annie Crooks**

Service No. **8**

Address **101 Meriam Street**

2076 - # 2077

Location

~~Renewal - New Service~~

WO # 8577

JUN 29 1964


Date	Material	Amount	Total	Date		Amount
5-1-64	Labor	2.31		3-5-64	Deposit	100.00
	10% O.H.	.23	2.54	6-29-64	<i>#</i> Retand	69.45
52	3/4" Copper tubing @.42		21.84			30.55
1	3/4" C x 1/2 I.W.H. Stop & Waste		<u>6.17</u>		NON CHARGE	
			30.55	5-1-64	Labor	2.22
					23' 3/4" Copper tubing @.42	9.66
					1 3/4" C Corp Cock	4.91
					1 3/4" C Curb Cock	6.28
					1 Box & Rod	4.90
					1 1/2 Straight tailpiece	.50
					1 1/2 Offset tailpiece	.50
						<u>28.97</u>
					<i>#</i> Appl 11.68 to S.H. # 15	

DATE _____

TOWN OF LEXINGTON — BOARD OF PUBLIC WORKS

WATER DIVISION

Sketch of Service Here

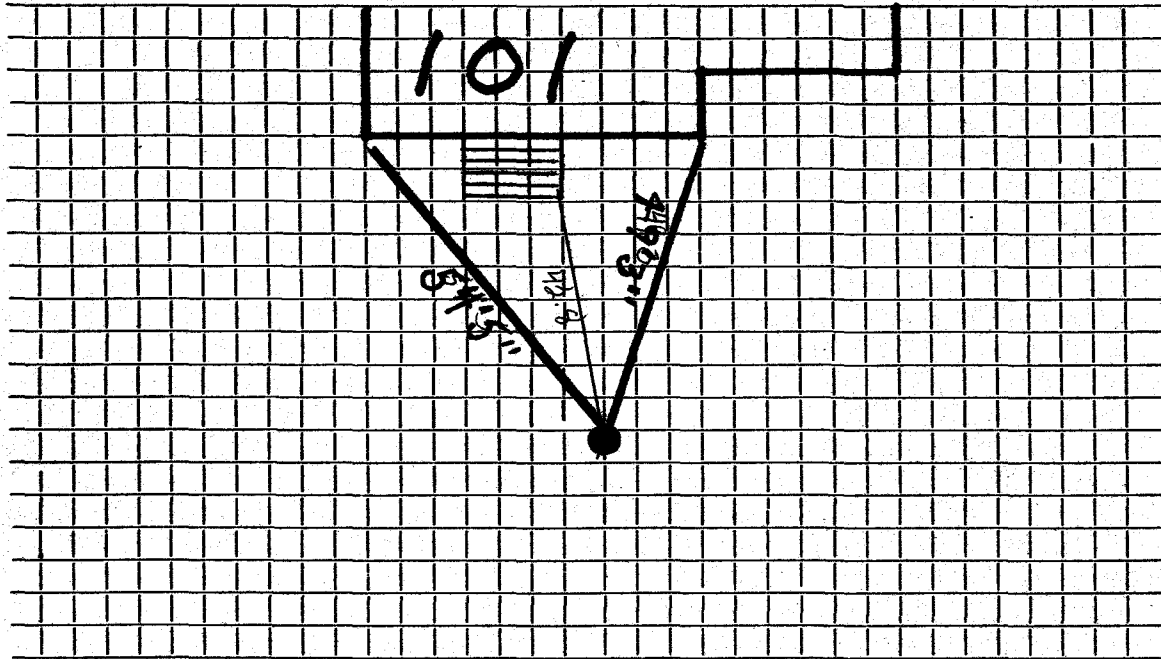

Connection made in Street. Work completed

Remarks:
.....
.....