

WATER SERVICE RECORD

Name

Service No.

Address 102 HERIAM ST.

Location

Repair—Renewal—New Service


Date	Material	Amount	Total	Date		Amount
8/19/92	<p><u>Outside</u> 21 LF 1" COPPER 1" CORP 1" CURB W/BOX .6" TAILPIECE 3/4" x 1" RED.</p>					
				12-3-	47' <u>Inside</u>	
					40' 3/4" Copper	
					1 3/4" C. X 1/2" l.w.h.	STOP + Waste

DATE _____

TOWN OF LEXINGTON — BOARD OF PUBLIC WORKS

WATER DIVISION

Sketch of Service Here

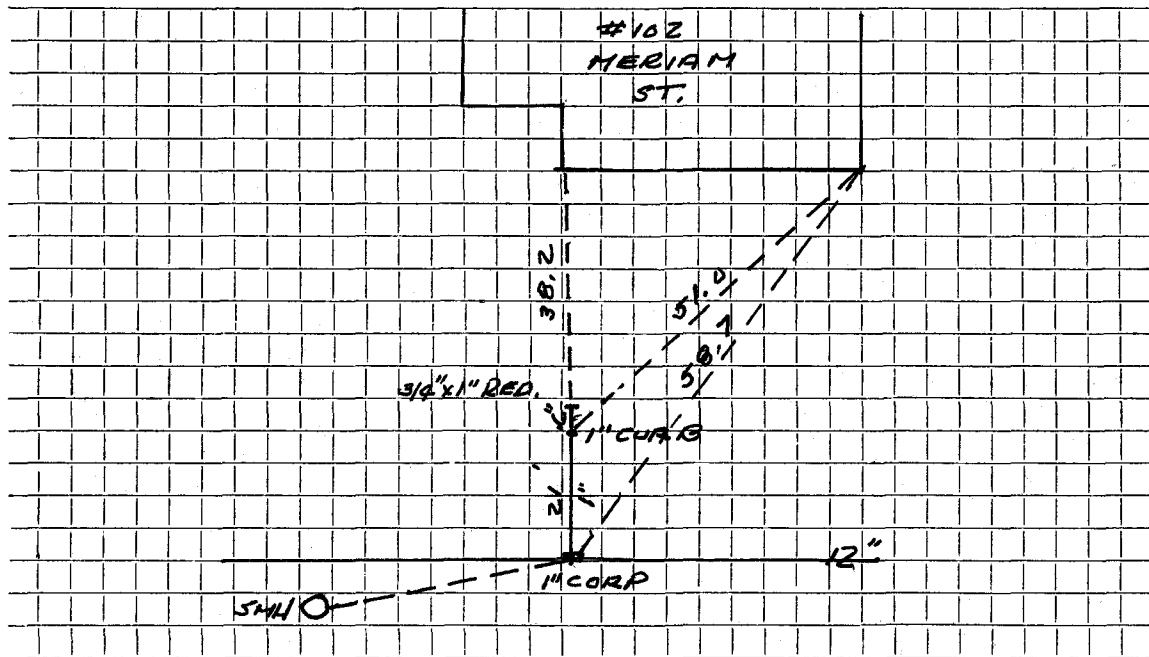

Connection made in MERIAM Street. Work completed

Remarks: BISBKO - O.S. CONTR.

.....

.....