


DATE _____

TOWN OF LEXINGTON — BOARD OF PUBLIC WORKS

WATER DIVISION

Sketch of Service Here

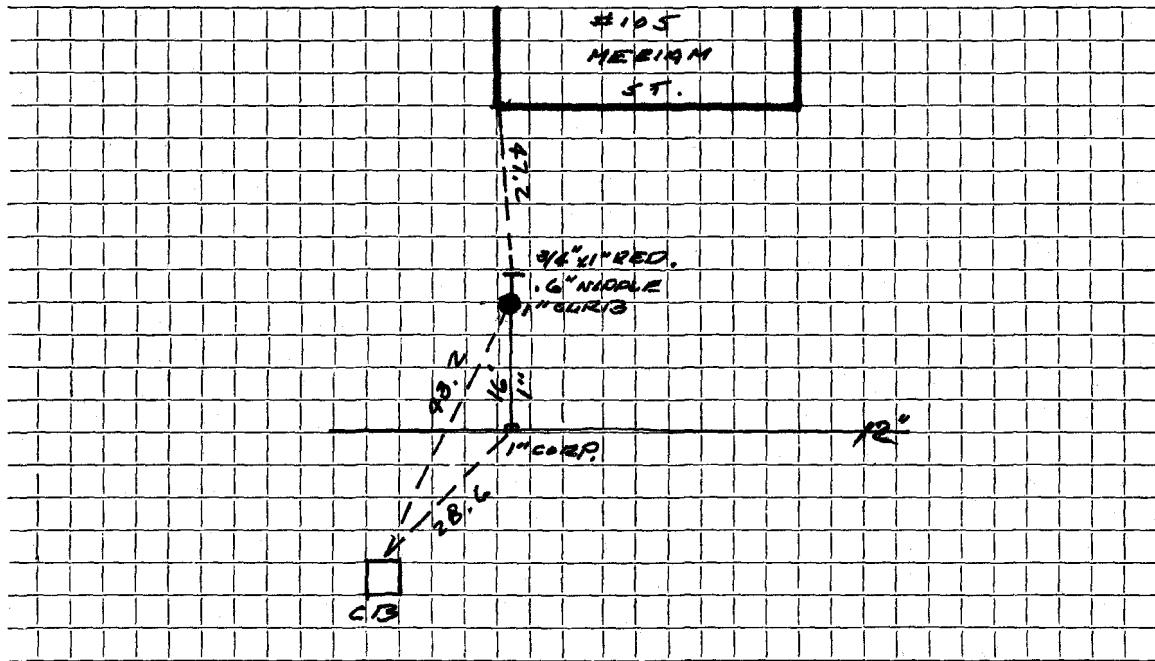

Connection made in HEBIAM Street. Work completed

Remarks: BISZKO - O. S. CONTR.