

Name Robert Merriam

Service No. 58 1946

Address 4 Oakmount Circle
12 Merriam St.

2631 - 2632

Location 12 Merriam (2nd on left) ~~12 Merriam~~

Kind of Pipe

Size

Size of Main

~~Repair - Renewal~~ New Service

Location

Date 1936	Material	Amount	Total	Date	Amount
Dec. 11	3 hrs @ 60¢	1 80		Feb. 5, 1937 Paid	24 00
Com 12-22-36	6 " 55¢	3 30	5 10		
	10% Overhead	51	5 61		
	48" 1" Cop. Tubing @ 21¢		10 08		
	1 S. and W.		1 75		
	Say:		17 44		
	48" @ 50¢		\$24 00		
				Bill sent 12-24-36	
				Phil + Chuck 11-28-77 Rod + Cutter went out 67' no blockage Just a test.	
	Labor				

Hadley Press, Inc., Lexington

DATE Dec 3rd 1936

TOWN OF LEXINGTON—BOARD OF PUBLIC WORKS

WATER DIVISION

The undersigned applies for a supply of water at No. 12 Merriam St. and hereby agrees to comply with the rules and regulations as now, or at any future time, established by the Board of Selectmen.

Am't. of Estimate \$ _____

Owner

Robert Merriam


Am't. Paid \$ _____

Address

4 Oakmount Circle
Lexington

Builder A G Black

Sketch of Service Here

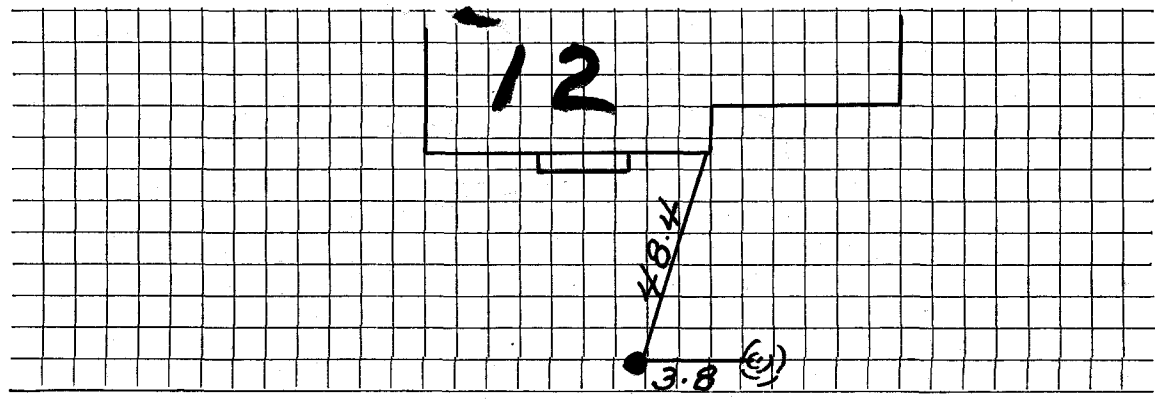

Connection made in _____ Street.

Work completed _____ 19

Remarks: