


DATE _____

TOWN OF LEXINGTON — BOARD OF PUBLIC WORKS

WATER DIVISION

Sketch of Service Here

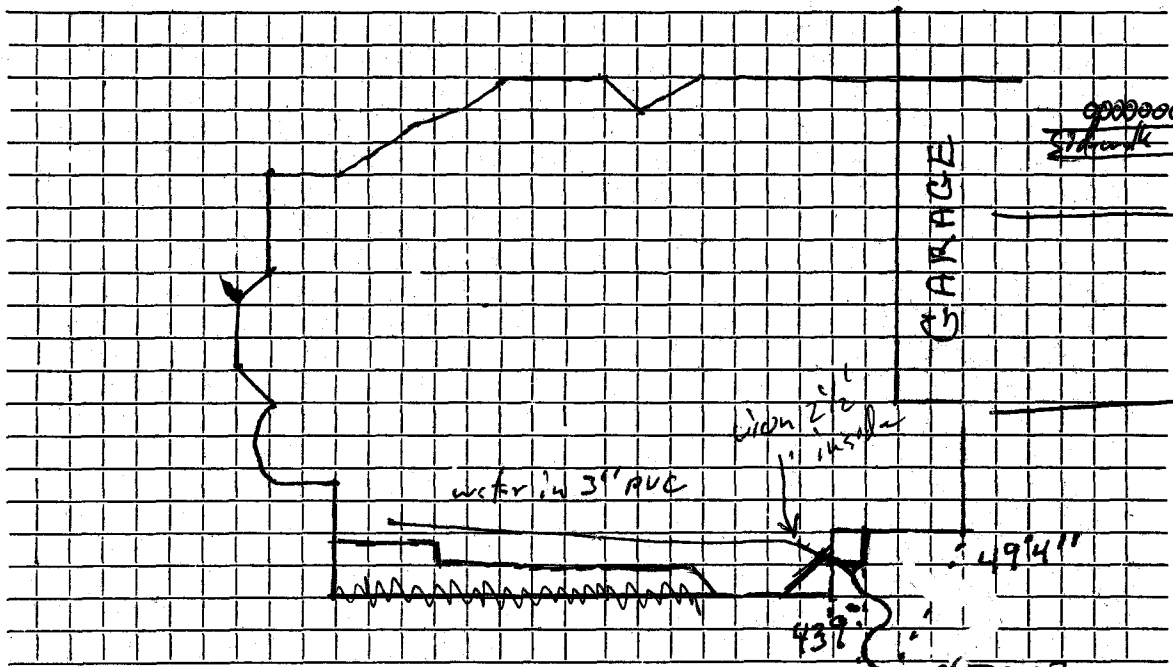

65 7' 49

6000000
Shank

52'

65/18A

water in 3" PVC

widen 2" inside

49' 4"

43'

5' DEEP

Connection made in Street. Work completed

Remarks:

.....

.....