

WATER SERVICE RECORD

Name

Service No.

Address

17 Merriam St / Oakland St

Greek Orthodox Church

Location


Repair—Renewal—New Service

Date	Material	Amount	Total	Date	Amount
	Merriam St.				
11/21/71	27' 1" Copper outside				
5/13/75	54.5" 1" copper inside				
	Oakland				
9-23-52	3/4" copper inside i.w.H. stop valve				
9-23-52	33' 3/4 copper outside				

TOWN OF LEXINGTON — BOARD OF PUBLIC WORKS

WATER DIVISION

Sketch of Service Here

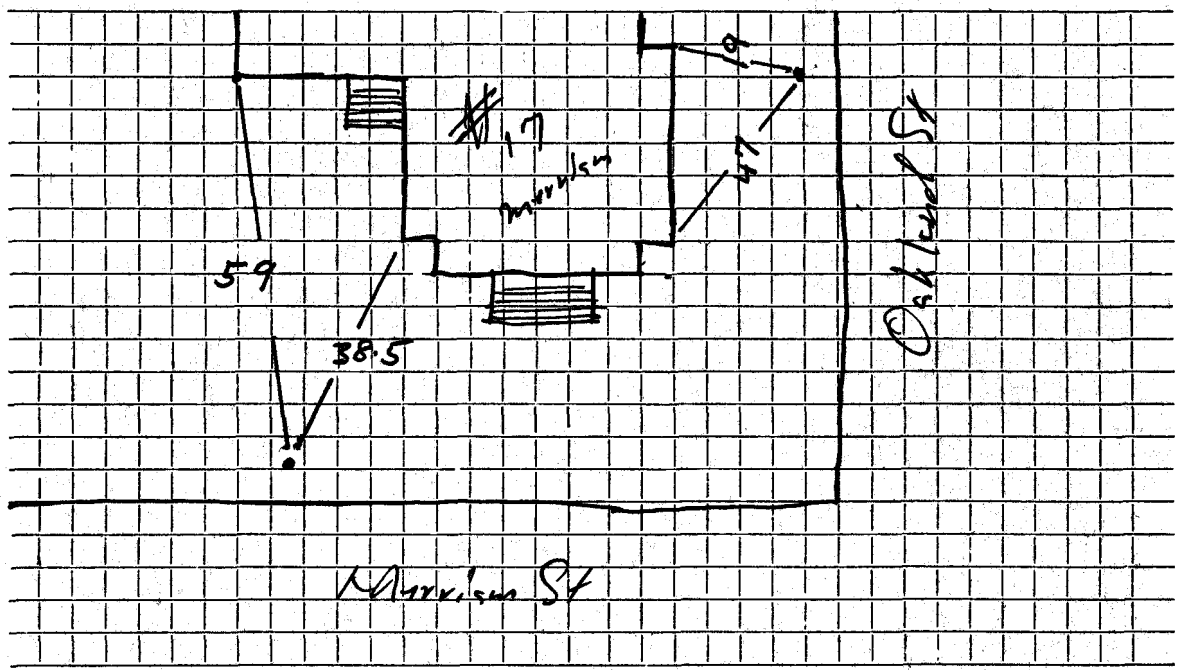

Connection made in Street. Work completed

Remarks: *This building has two services... one on Morrison St... one on Oakland St.*