

WATER SERVICE RECORD

Name

Service No.

Address

Location **18 MERIAM**

Repair—Renewal—New Service


Date	Material	Amount	Total	Date	Amount
8-6-48	60' $\frac{3}{4}$ " Copper				
	1 $\frac{3}{4}$ " C. X $\frac{3}{4}$ " C. I.W.H. Stop & Waste				
				8-6-48	
				48' $\frac{3}{4}$ " Copper	
				1 $\frac{3}{4}$ " C. Corp Cock	
				1 $\frac{3}{4}$ " C. X $\frac{3}{4}$ " C. Curb Cock	

DATE 6-28-1999

TOWN OF LEXINGTON — BOARD OF PUBLIC WORKS

WATER DIVISION

Sketch of Service Here

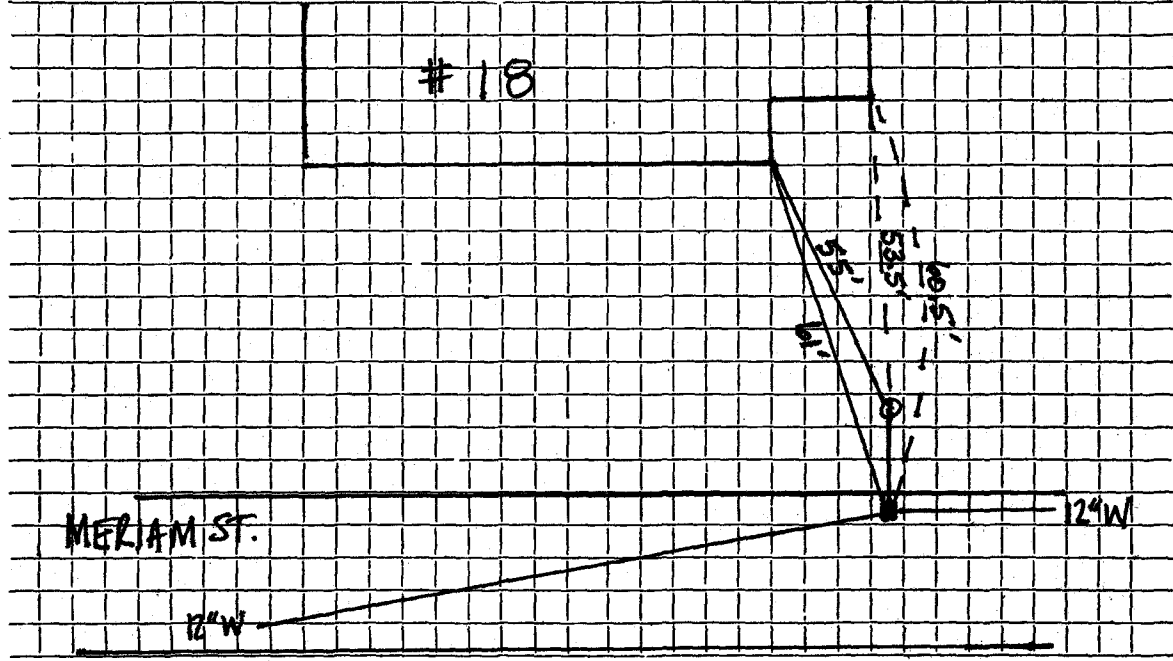

Connection made in 12" MAIN ON MERIAM Street. Work completed NEW CONNECTION, CURBSTOP/BOX

Remarks: 12" MAIN STARTS TO CROSS OVER TO OPPOSITE SIDE OF MERIAM ST.