

Name Mrs. L. C. Robinson

Service No. ~~20~~ 1951

Address 19 Merriam Street

#5907

Location

Kind of Pipe

Size

Size of Main

~~Repair~~—Renewal—~~New Service~~

Location

Date
1940

Material

Amount

Total

Date

Amount

June 20

33 hrs. @ 60¢

19 80

1 " @ 65¢

65¢

20 45

10% Overhead

2 04

44' 3/4" Copper tubing @ 18¢

7 92

1 3/4" C x 1/2" I S. & W.

2 25

1 3/4" C. Union (3 part)

90

1 3/4" C. x 3/4" I. Union

65

2 hrs. trucking @ 75¢

1 50

36 71

July 8, 1940 Paid

35 71

Rec'd sent 7/1/40

Labor

6-27 86

1 - RdWAY Box

Hadley Press, Inc., Lexington

DATE _____

TOWN OF LEXINGTON—BOARD OF PUBLIC WORKS

WATER DIVISION

The undersigned applies for a supply of water at No. _____ St. and hereby agrees to comply with the rules and regulations as now, or at any future time, established by the Board of Selectmen.

Am't. of Estimate \$ _____


Owner _____

Am't. Paid \$ _____

Address _____

Builder _____

Sketch of Service Here

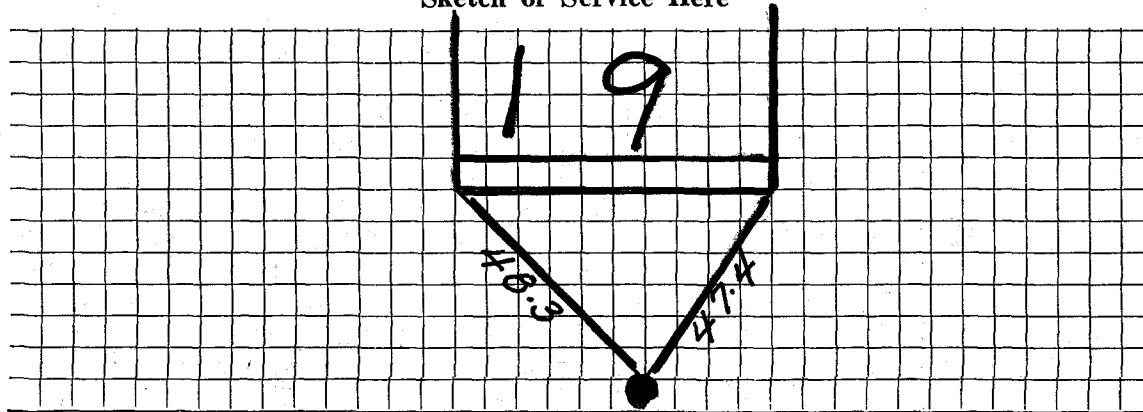

Connection made in Need wrench for 2"-10 Rod Street.

Work completed _____ 19

Remarks: Curb in backwards

ON Curb