

Name Willard D. Brown

Service No. ~~4~~ 1952

Address 20 Meriam Street

5766

Location Same

Kind of Pipe

Size

Size of Main

~~Repair~~—Renewal—~~New Service~~

Location

Date	Material	Amount	Total	Date	Amount
9/7/35	52 Hrs. @ 55¢	28 60		Sept 3 1935	58 00
Com. to Renewal	3 " @ 60¢	1 80		Nov. 21, 1935	<u>7 06</u>
# 50.64-10-22-73	10% Ovhd. On labor	3 04			50 64
	56' 3/4" Copper @ 20¢	12 20			
	1 Stop & Waste	2 00			
	Trucking	3 00			
			\$50 64		
	Labor				

Hadley Press, Inc., Lexington

DATE August 26, 1935

TOWN OF LEXINGTON—BOARD OF PUBLIC WORKS

WATER DIVISION

The undersigned applies for a supply of water at No. 20 Main St. and hereby agrees to comply with the rules and regulations as now, or at any future time, established by the Board of Selectmen.

Am't. of Estimate \$ 58.⁰⁰


Owner _____

Am't. Paid \$ _____

Address _____

Builder _____

Sketch of Service Here

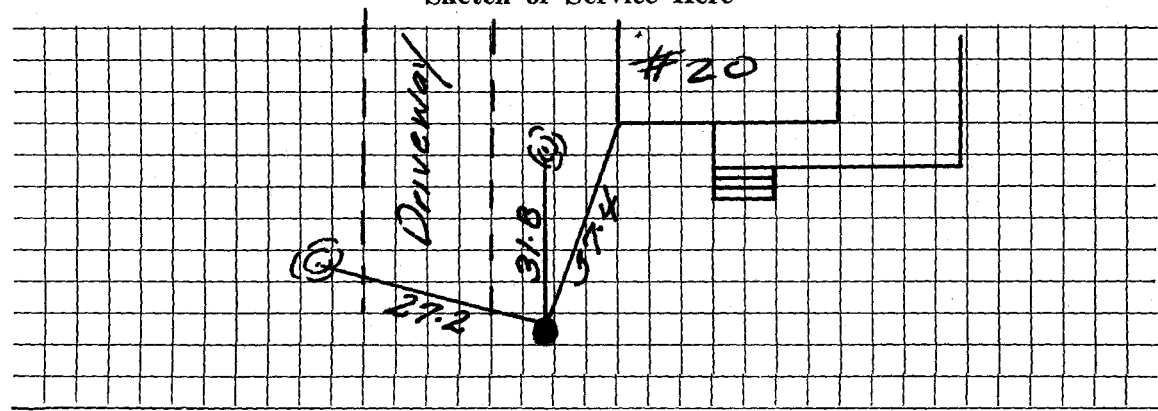

Connection made in _____ Street.

Work completed _____ 19

Remarks: