

WATER SERVICE RECORD

#5316

Name Mrs. Gardner Maxcy

Service No. 55

Address 23 Meriam St.

Location

~~Repair—Renewal—New Service~~ W.O. #7415

JAN 27 1969


Date	Material	Amount	Total	Date	Amount	
10/9/68	Labor	55 80		9-25-68	Deposit	275 00
10/16/68	"	18 56	74 36	1-27-69	Refund	126 11
	10% O.H.		7 44			148 89
39	3/4" Copperpipe .79		30 81		Outside	
	3/4"x1/2" Stop & waste		11 13	10/9/68	Labor	29 89
	1 Yd. Loam		3 50	10/16/68	"	27 10
	1 Lb. Grass seed		1 10	18'	3/4" Copperpipe .79	14 22
	1 Bag cement		1 55		3/4" Curb Stop	8 37
	2 Hrs. Trucking 3.00		6 00		Box & Rod	5 10
	2 " Shovel 6.50		13 00		Corp. Adapt	2 76
			148.89	3/4	Ton hot top 5.80	4 35
				1	Hr. Shovel	6 50
				1	" Trucking	3 00
				1 1/2	" " 1.50	2 25
				1/2	" Roller 3.00	1 50
					Trailer	2 00
						107 04

DATE _____

TOWN OF LEXINGTON — BOARD OF PUBLIC WORKS

WATER DIVISION

Sketch of Service Here

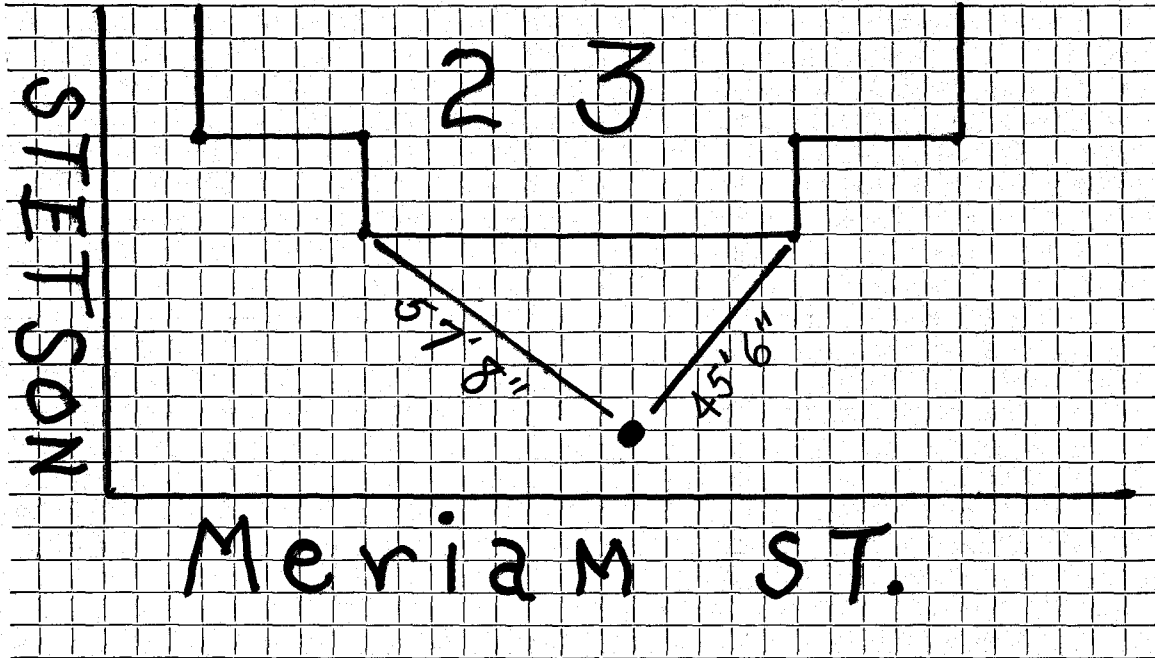

Connection made in Street. Work completed

Remarks:
.....
.....