




Date: 11/17/22

TOWN OF LEXINGTON - BOARD OF PUBLIC WORKS  
WATER DIVISION

SKETCH OF SERVICE HERE

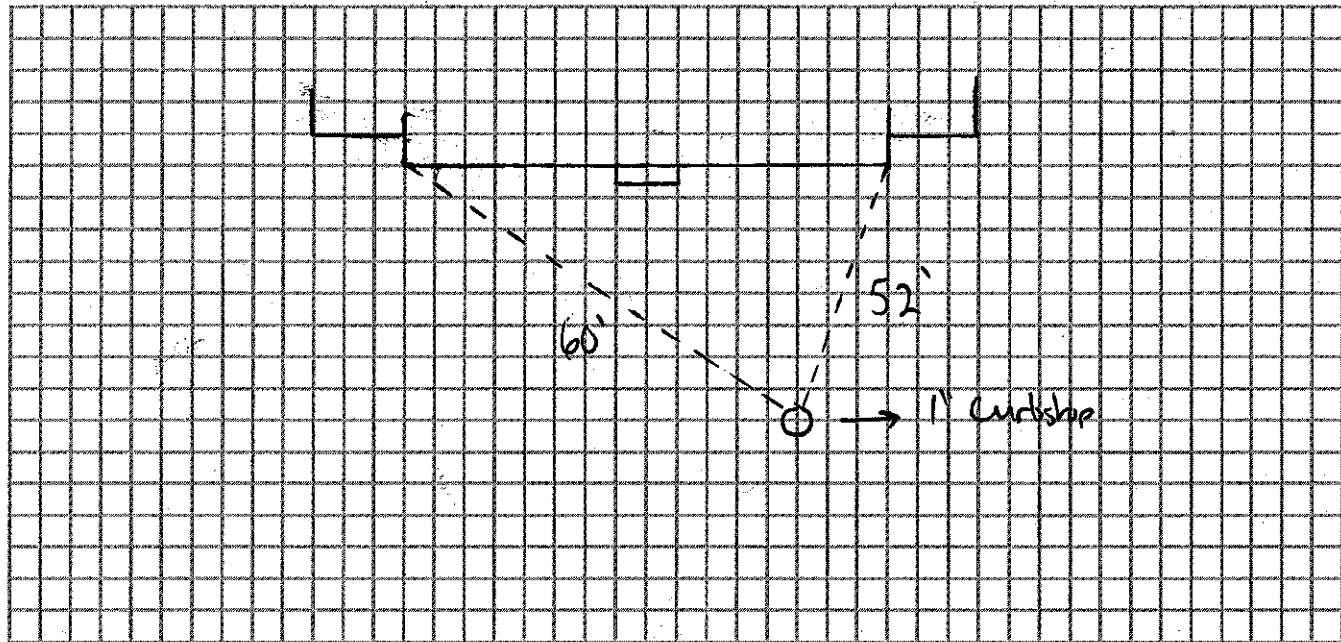

Connection made in: \_\_\_\_\_ Street. Work completed: \_\_\_\_\_  
Remarks: INSTALLED BY DAVID SANTO