

WATER SERVICE RECORD

Name Mrs P. A. Northrop

Service No. 3

Address 25 Meriam Street

Location

~~Renewal~~ ~~New Service~~ W.O. #1615

JUN 23 1966


Date	Material	Amount	Total	Date	Material	Amount
3-7-66	Labor	128 99			<u>CURB TO MAIN</u>	
	10% O.H.	12 90	141 89	3-22-66	Patch 53.20	
	60' 1" copper tubing @ .99		59 40	3-23-66	Patch 27.16	80.36
	1 1 x 3/4 Wheel valve		9 69		10% O.H.	8.04
	2 Hrs. Truck @ 3.00		6 00	28'	1" copper tubing @ .99	27 72
	6 Hrs. Tractor @ 6.5 0		39 00	1	1" Curb	11 15
			255 98	1	Curb Box	
					26 x 3 Patch	26 00
				2	Ton hot top @ 5.50	11 00
				5	Yards Loam @ 3.00	15 00
				1	Lb. seed	1 05
				1/2	Bag Fertilizer @ 4.00	2 00
				1	Hr. Roller	3 00
				1	Hr. Trailer	2 00
				1	Hr. Compressor	5 00
				1-14-66	Deposit	225 00
					Bill sent	30 98

DATE _____

TOWN OF LEXINGTON — BOARD OF PUBLIC WORKS

WATER DIVISION

Sketch of Service Here

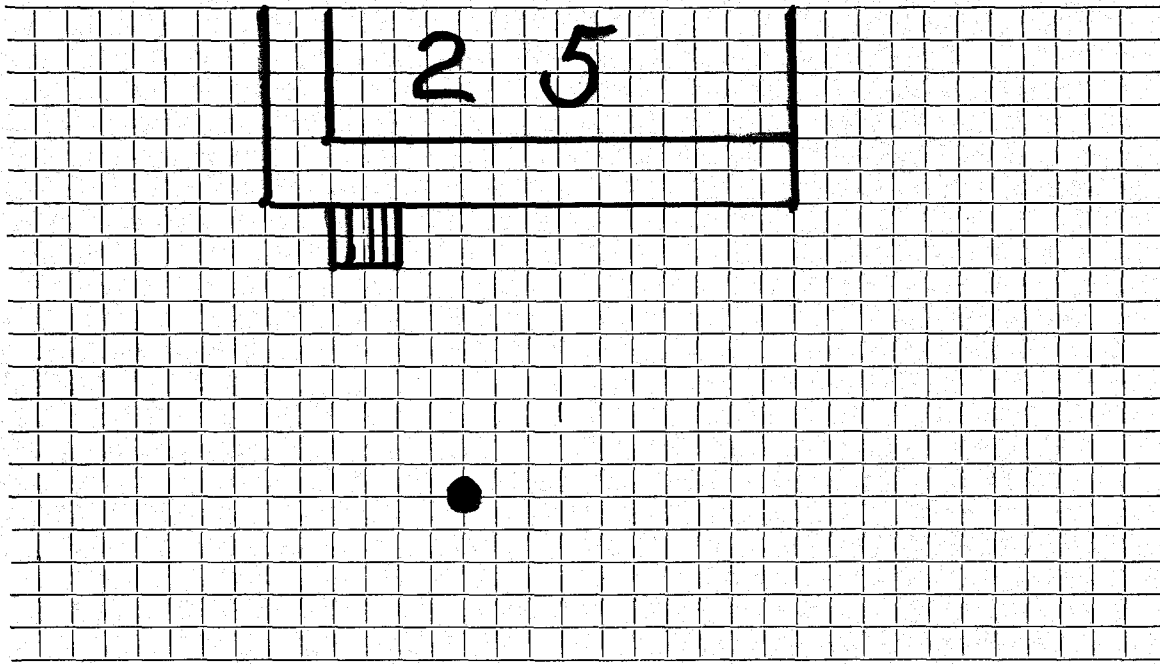

Connection made in Street. Work completed

Remarks:
.....
.....