

WATER SERVICE RECORD

Name John F. Rich

Service No. 132

Address 27 Meriam Street

Location


~~Renewal~~ ~~New Service~~ W.O. #7618

Comm 12-10-62

Date	Material	Amount	Total	Date	Amount
10-18-62	Labor	33.80		9-20-62	150.00
10-19-62	"	23.71	57.51	12-10-62	29.37
44'	10% O.H. tubing	18.75	63.26		130.64
1	1" X 3/4" I.W.H. Stop & Waste	6.96			
44'	1" Copper tubing @56	24.64			
					NON CHARGE
3 1/2	Hrs. Town Shovel @6.50	22.75	22.75	10-16-62	Labor 15.73
1	Hr. Trucking @3.00	3.00	3.00	12'	1" Copper tubing @56 6.72
			120.61	1	1" C Corp Cock 7.31
				1	1" Curb Cock 8.06
				1	Box & Rad 4.90
				10	X 3 Patch 10.00
				1 1/2	Hr. Town Shovel @6.50 9.75
				1	Hr. Trucking @3.00 3.00
					<u>65.47</u>

TOWN OF LEXINGTON — BOARD OF PUBLIC WORKS  
WATER DIVISION

Sketch of Service Here

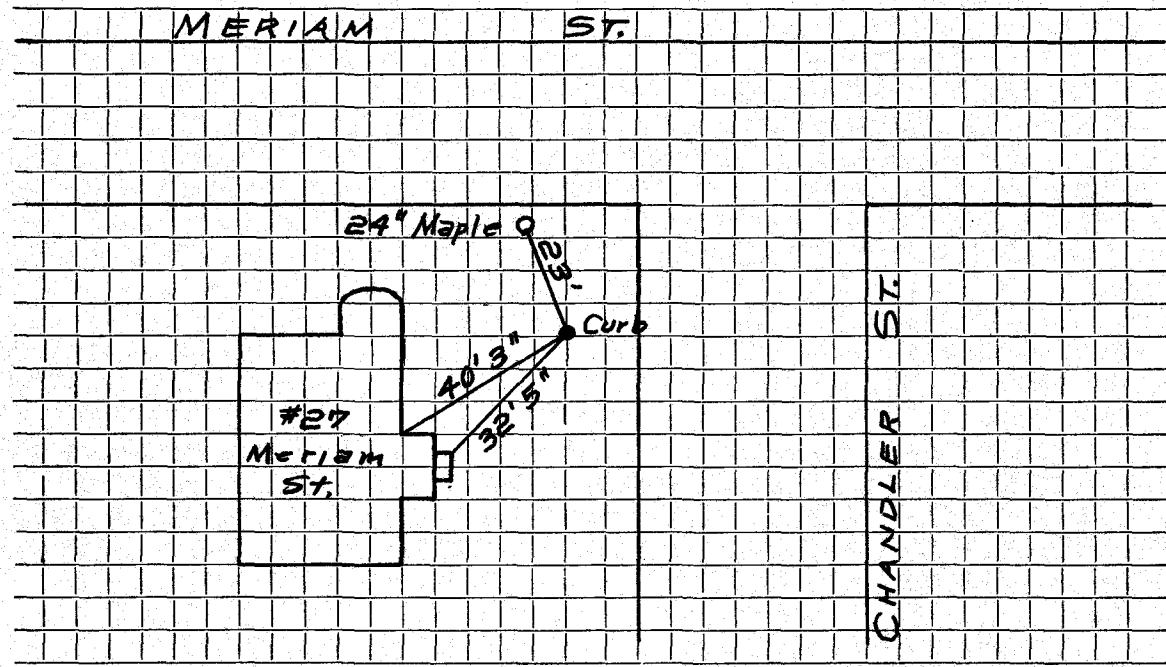

Connection made in ..... Street. Work completed .....

Remarks: .....  
.....  
.....