

Name Harvey Newjert

Arlington

Service No.

1958
37-328

Address 31 Merriam Street
139 Highland Avenue
Arlington, Mass.

Location 31 Merriam Street

Kind of Pipe

Size

Size of Main

~~Repair~~ ~~Renewal~~ New Service

Com 9-16-46

Location

Date	Material	Amount	Total	Date	Location	Amount
June 20 '46	Labor	-- 90	-- 90	<i>June 1, '46</i>	<i>Deposited</i>	15 00
	10% overhead		09			
	55'-3/4" copper tubing		9 98			
	1-3/4 Cx3/4" I.W.H. stop&Waste		2 82			
	1-hr. trucking		75	June 20 '46	Non-Charge	
			\$14 54		Labor	1 80
					13'-3/4" copper tubing	2 36
					1-3/4" c.corp-cock	2 70
					1-3/4" c.x 3/4" curb	3 30
					cock	
					1-box and rod	1 65
					1-3/4" offset tail pc	90
					1-3/4" straight "	90
					1-hr. trucking	75
	Labor					14 36

Hadley Press, Inc., Lexington

TOWN OF LEXINGTON—BOARD OF PUBLIC WORKS WATER DIVISION

The undersigned applies for a supply of water at No. _____ St. and hereby agrees to comply with the rules and regulations as now, or at any future time, established by the Board of Selectmen.

Am't. of Estimate \$ _____


Owner _____

Am't. Paid \$ _____

Address _____

Builder _____

Sketch of Service Here

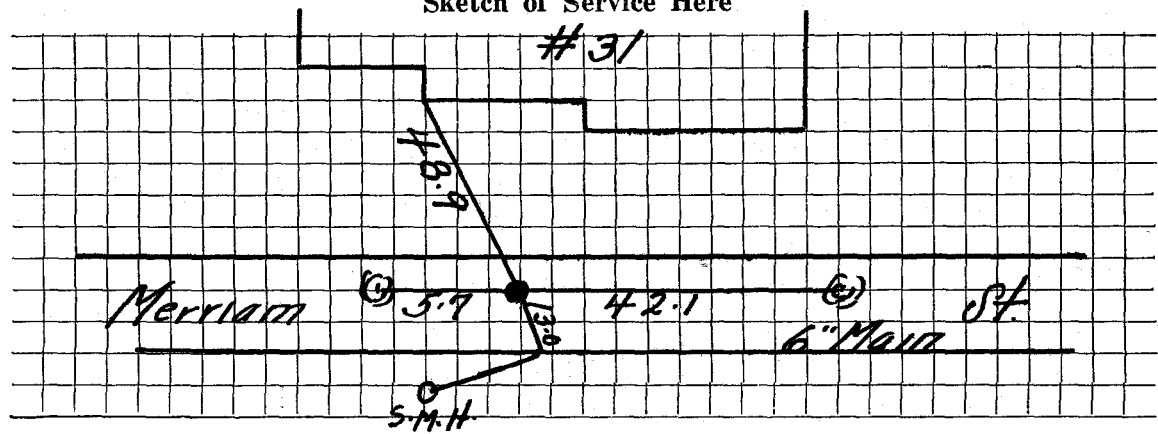

Connection made in _____ Street.

Work completed _____ 19


Remarks:

DATE 6-29-1999

TOWN OF LEXINGTON — BOARD OF PUBLIC WORKS

WATER DIVISION

Sketch of Service Here

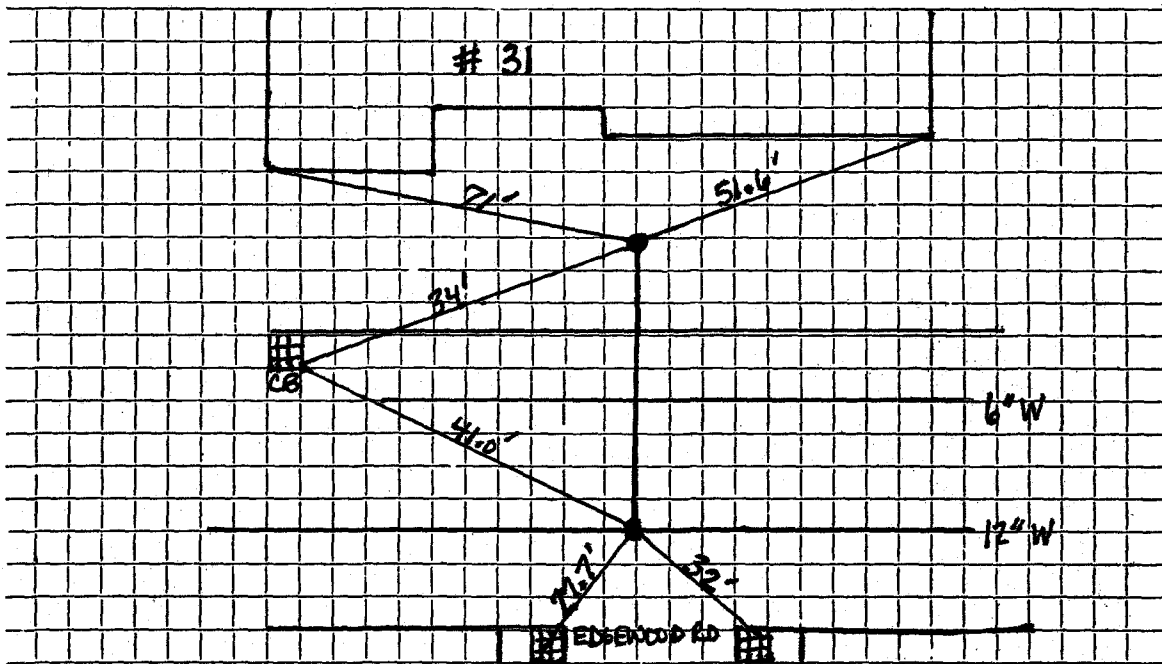

Connection made in 12" MAIN ON MERIAM Street. Work completed NEW CORPORATION, CURBSTOP/BOX

Remarks: