

WATER SERVICE RECORD

Name Win S. Couette

Service No. 15

Address 35 Merriam Street

Location

~~Renewal~~ - Renewal - ~~NEW SERVICE~~

Com. 3-21-55


Date	Material	Amount	Total	Date	Amount
1/21/55	Labor	19 25		1-21-55	Deposited 100 00
	10% overhead	1 93	21 18	3-21-55	Refunded 30 77
	38' - 3/4" copper tubing@ .35		13 30		<u>NON CHARGE</u> 69 23
	1 - 3/4"C x 1/2 I.W.H. stop & waste	4 00		1/21/55	Labor 19 25
	4 hrs. Littlefield shovel@ 7.50		30 00		7' - 3/4" copper tubing@.35 2 45
	1 hr. trucking		<u>75</u>		1 - 3/4"C. corp-cock 4 33
			69 23		1 - 3/4"C. curb-cock 4 67
					1 box and rod 3 90
					1 - 1/2 straight tail piece 50
					1 - 1/2 offset tail piece 50
					2/3 hr. Littlefield @ 7.50 5 00
					1 hr. trucking <u>75</u>
					41 35

DATE _____

TOWN OF LEXINGTON — BOARD OF PUBLIC WORKS

WATER DIVISION

Sketch of Service Here

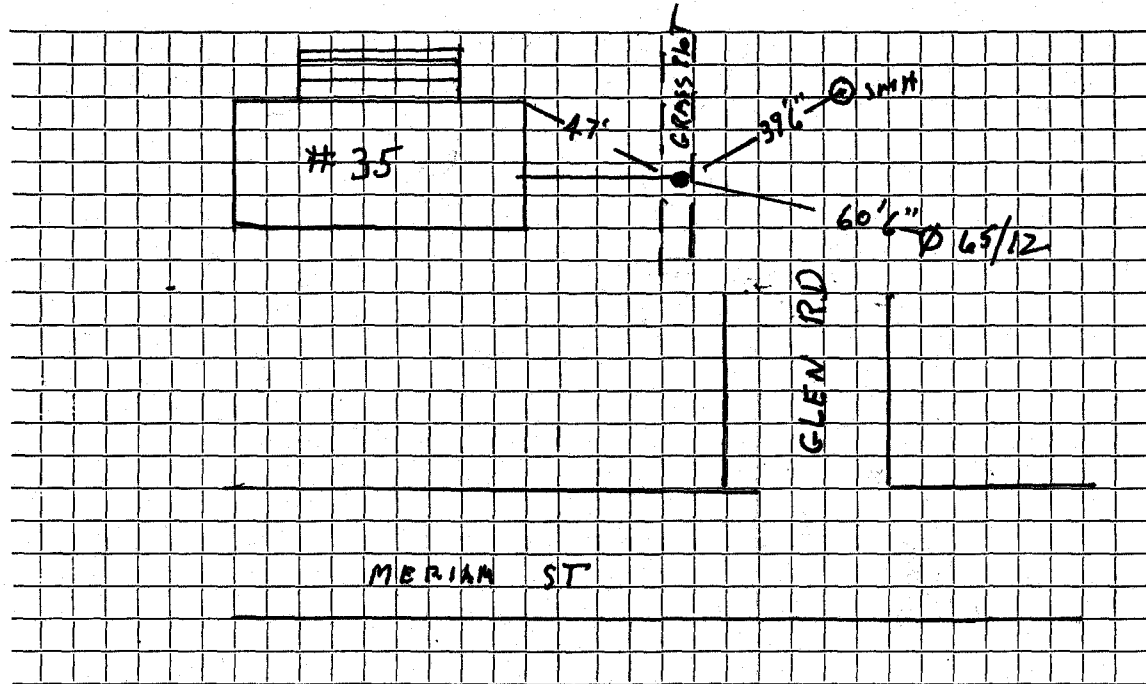

Connection made in GLEN RD. Street. Work completed

Remarks:

.....

.....