


DATE _____

TOWN OF LEXINGTON — BOARD OF PUBLIC WORKS

WATER DIVISION

Sketch of Service Here

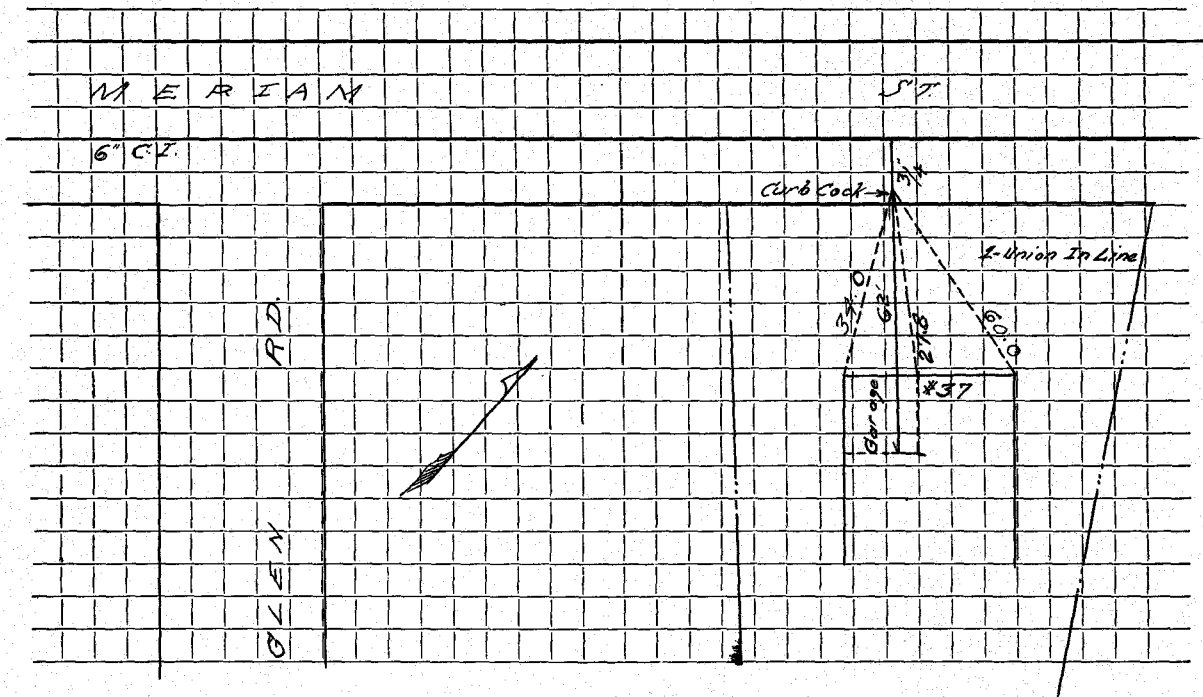

Connection made in Street. Work completed


Remarks:
.....
.....

DATE 6-28-1999

TOWN OF LEXINGTON — BOARD OF PUBLIC WORKS

WATER DIVISION

Sketch of Service Here

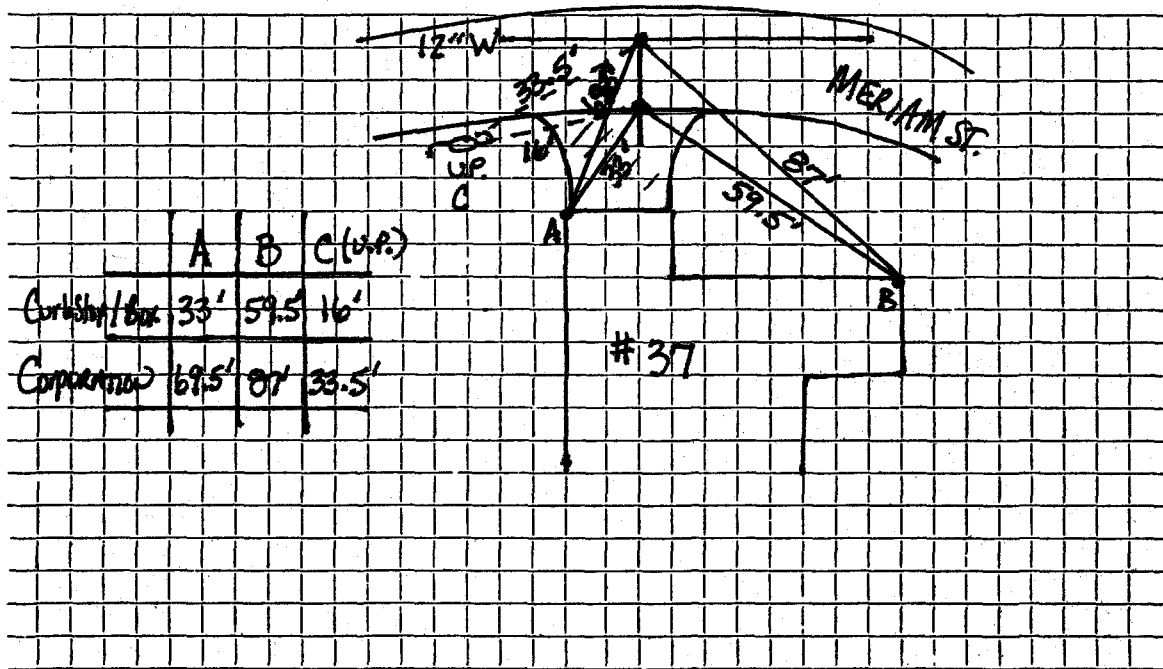

	A	B	C (U.P.)
Curbstop/Box	33'	59.5'	16'
Corporation	69.5'	87'	33.5'

Connection made in 12" MAW ON OPPOSITE SIDE OF MERIAM Street. Work completed NEW CORPORATION, CURBSTOP/BOX

Remarks: CURBSTOP/BOX SITS EXACTLY ON TOP OF SEWER PIPE (WHITE ASBESTOS PIPE)