

## WATER SERVICE RECORD

Name William Barnes

Service No. 15

Address 38 Meriam St.

Location

~~Repair - Renewal~~ New Service W0#4259 Kel Scott #2820

AUG 16 1976


Date	Material	Amount	Total	Date	Amount
4/22/76	labor	21. 26		4-16-76	Deposit 300. 00
	10%OH	2. 12	23. 38	8-16-76	Refund 77. 73
	21' 1" copper tubing @ .83		17. 43		222. 27
	1 1" curb stop		18. <del>40</del>		
	1 1" corporation		16. 69		
	1 box and rod		15. 40		
	side-walk 5' X 13' patch		43. 20		
	street patch 6' X 20'		78. 00		
	3hr. truck @ 3.00		9. 00		
	$\frac{1}{2}$ hr. roller		<u>1. 00</u>		
			222. 27		
5/11/76	35' 1" Copper Tubing				

DATE \_\_\_\_\_

**TOWN OF LEXINGTON — BOARD OF PUBLIC WORKS**

**WATER DIVISION**

Sketch of Service Here

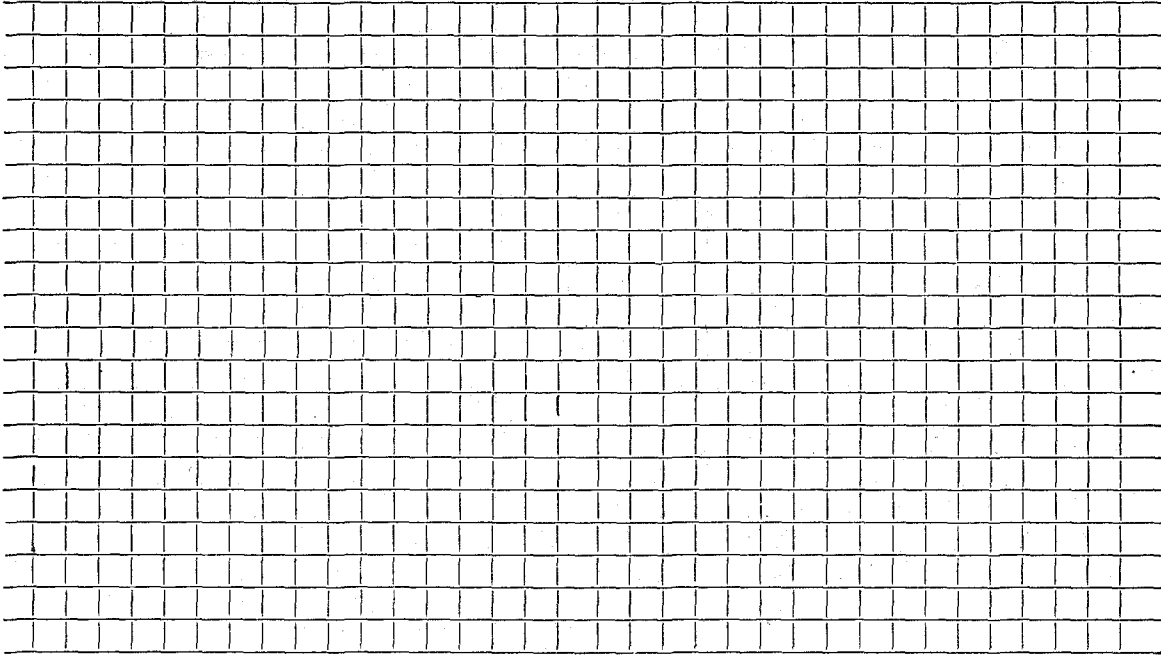

Connection made in ..... Street.                      Work completed .....

Remarks: .....  
.....  
.....