


DATE 6-24-1999

TOWN OF LEXINGTON — BOARD OF PUBLIC WORKS

WATER DIVISION

Sketch of Service Here

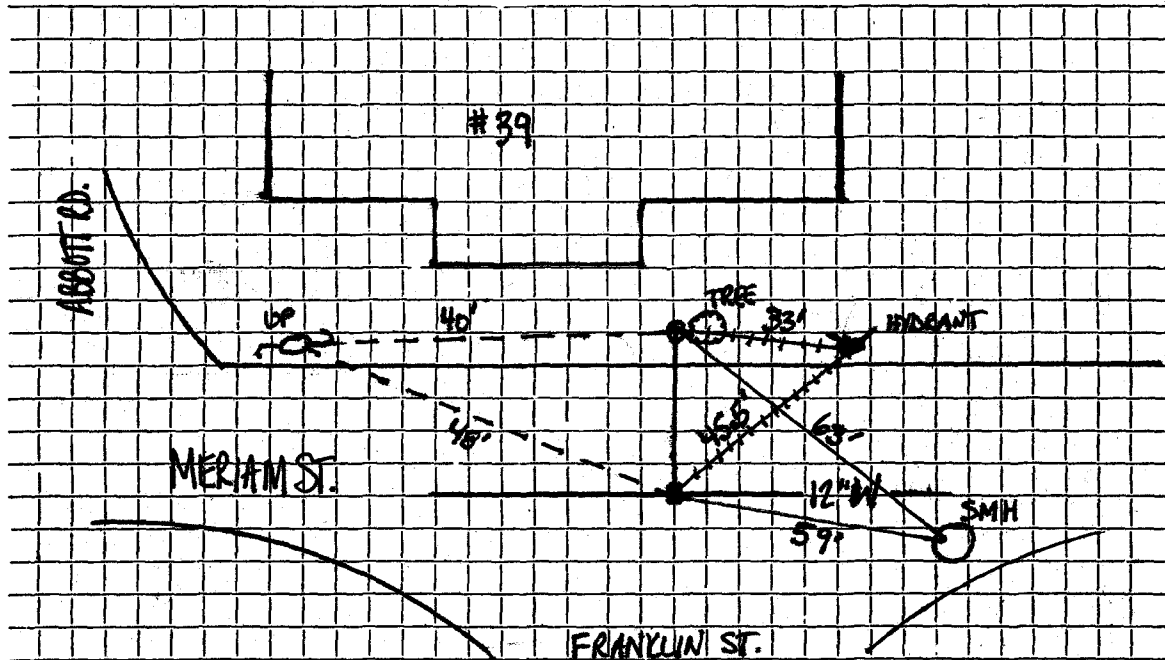

Connection made in 12" MAIN, MAIN ~ 5' DEEP FROM PAVEMENT Street.

Work completed NEW CORPORATION, UNION

Remarks: * BAD ELECTRICAL GROUND NOTED BY BISZKO CONT. ON/NEAR BOX/UNION.

Name James L. Barrington

Service No. ~~87~~ 1960

Address Hotel Sheraton, Boston, Mass.

2064

39 Meriam St.

Location #39 Merriam St.,

Kind of Pipe

Size

Size of Main

~~Repair-Renewal~~ - New Service

Location

Date 1938	Material	Amount	Total	Date	Amount
Dec. 21	Labor on Sewer Acct. #28			November 29, 1938	30 00
<i>Jan 2-4-39</i>	67' 1" Copper Tubing @ 20¢		13 40	<i>Deposited</i>	
	1 1" C. S. & W.		3 75		
	2 hrs. trucking @ 75¢		1 50		
			18 65		
	Flat Rate say. 60' @ 50¢		\$30 00	<i>Rec'd 7/9/39</i>	
	Labor				

Hadley Press, Inc., Lexington

2 Merriam St

DATE Mar. 16. 1938.

TOWN OF LEXINGTON—BOARD OF PUBLIC WORKS

WATER DIVISION

*Cor. Merriam St. #37 Merriam St.
& Abbott Road.*

The undersigned applies for a supply of water at No. _____ St. and hereby agrees to comply with the rules and regulations as now, or at any future time, established by the Board of Selectmen.

Am't. of Estimate \$ 30⁰⁰

Owner J. L. Barrington
Hotel Sherraton


Am't. Paid \$ _____

Address By Geo W Woodland & Son
Builders
509 High St
West Medford

Builder _____

Mail east 1/2 block

Sketch of Service Here

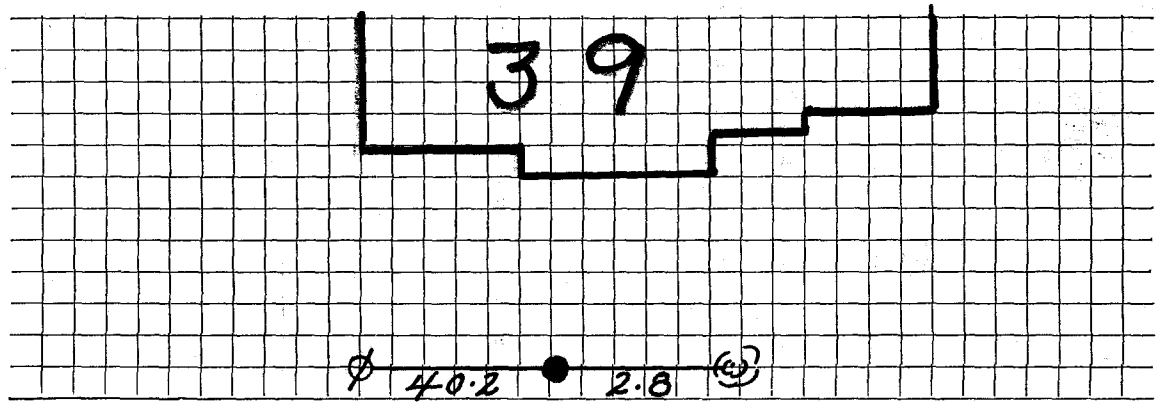

Connection made in _____ Street.

Work completed _____ 19

Remarks: