

Name Newton Crandall

Service No. 112

Address 40 Meriam Street

5324
5325

Lexington, Mass.

Location 40 Meriam Street

Kind of Pipe

Size

Size of Main

~~Repair & Renewal~~ - New Service

Location

Date	Material	Amount	Total	Date	Location	Amount
Aug. 23, '48	Labor	1 53	1 53	Aug. 6, '48	Deported	25 00
	10% Overhead		15			
	60' - 1" Copper Tubing @.31		18 60		Non-Charge	
	1 - 1" C x 1" I.W.H. S&w		3 15	Aug. 23, '48	Labor	1 53
	1 - 1" C x 1" C Union(3pts)		1 74		40' - 1" Copper Tubing @.31	12 40
	Trucking 1 hr. @.75		75		1 - 1" C Corp-cock	3 96
			25 92		1 - 1" C x 1" Curb-cock	4 80
					1 - Box & Rod	3 55
					1 - 1" Straight Tail Piece	30
					1 - 1" Offset Tail Piece	30
					Trucking 1 hr. @.75	75
	Labor					27 59

~~7-29-65~~ POTS


Hdley Press, Inc., Lexington

DATE 6-23-99

TOWN OF LEXINGTON — BOARD OF PUBLIC WORKS

WATER DIVISION

Sketch of Service Here

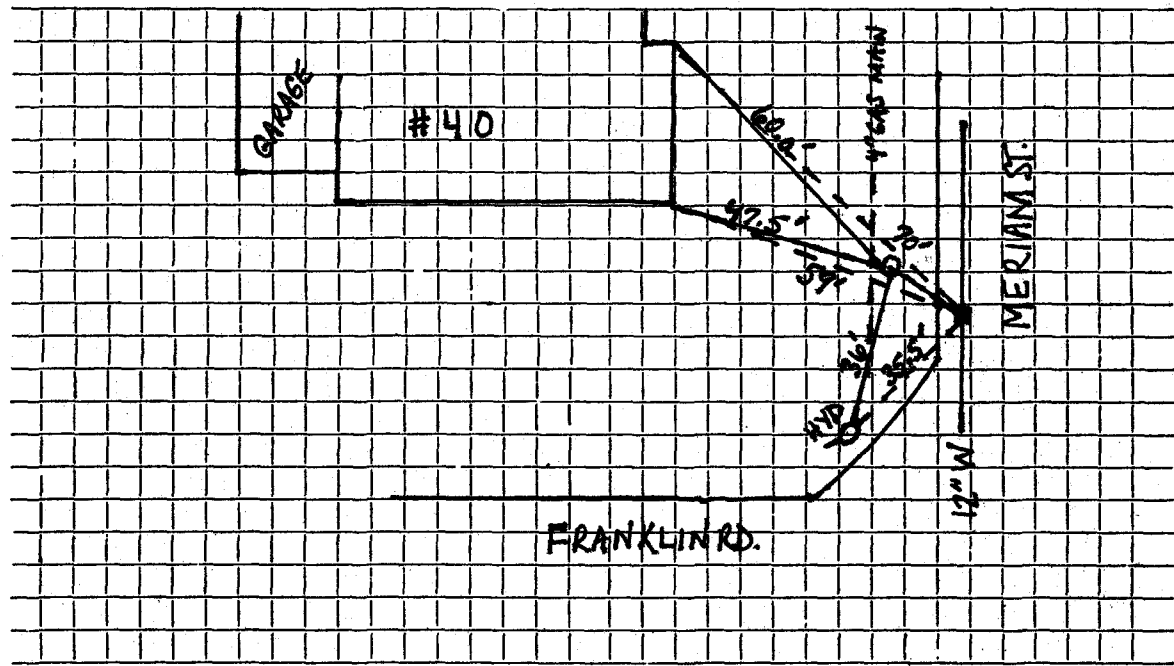

Connection made in GUTTER LINE, 2.5' AWAY FROM CURB Street. Work completed

Remarks: CURB STOP/BOX LOCATED ADJACENT TO 4" CAST IRON GAS MAIN

12" WATER MAIN ~ 2.5' OFF CURB.