

WATER SERVICE RECORD

Name Leeland Const. Co., Inc.

Service No.

# 5049  
297 # 4742

Address 41 Merriam Street

Location

~~ROAD WORK~~ - New Service

*Com 12-31-54*

Date	Material	Amount	Total	Date	Amount
11/24/54	Labor	6 40		11-23-54	Deposited 50 00
	10% overhead	64	7 04	12-31-54	* Refunded 7 46
	45' - 3/4" copper tubing @ .35		15 75		<u>NON CHARGE</u> 42 54
	1 - 3/4" C x 1/2 I.W.H. stop & waste		4 00	11/24/54	Labor 7 40
	2 hrs. Littlefield shovel	7.50	15 00		5' - 3/4" copper tubing @ .35 1 75
	1 hr. trucking		75		1 - 3/4" C. corp-cock 4 33
			42 54		1 - 3/4" C Curb-cock 4 67
					1 box and rod 3 90
					1 - 1/2 offset tail piece 50
					1 - 1/2 straight tail piece 50
					1 hr. Littlefield shovel 7 50
					1 hr. trucking 75
					31 30


\* \$ 4.60 of this refund made payable to town to apply on balance due on s.b.c. #174

DATE \_\_\_\_\_

TOWN OF LEXINGTON — BOARD OF PUBLIC WORKS

WATER DIVISION

Sketch of Service Here

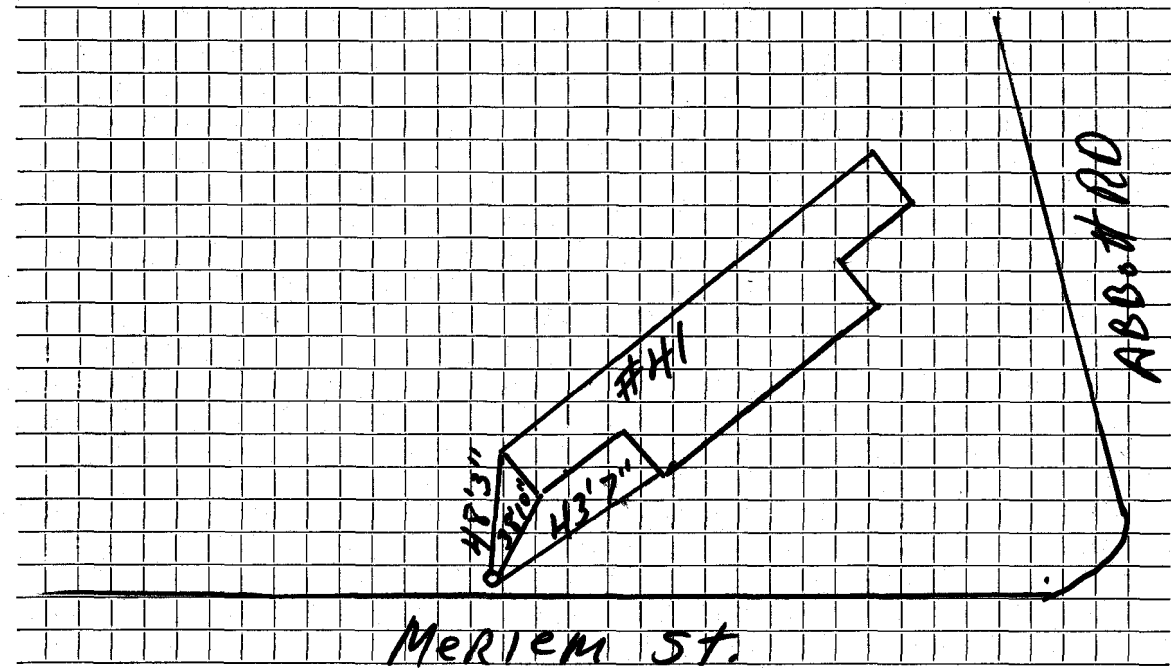

Connection made in ..... Street. Work completed .....

Remarks: .....  
.....  
.....




DATE 6-23-1999

TOWN OF LEXINGTON — BOARD OF PUBLIC WORKS

WATER DIVISION

Sketch of Service Here

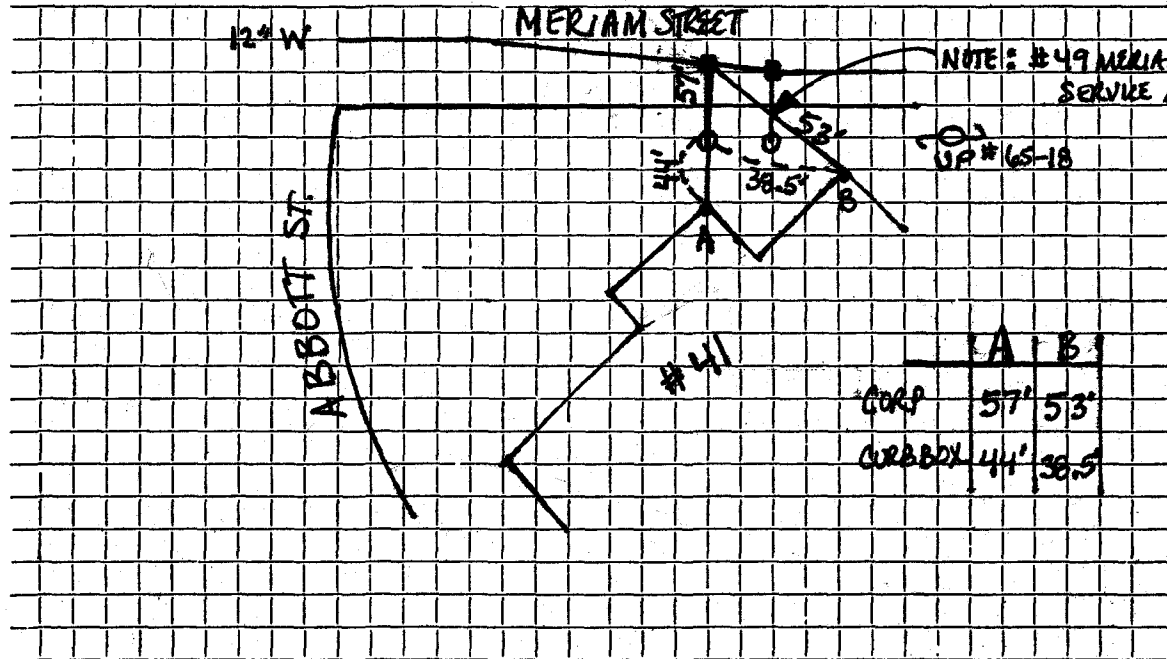

Connection made in 12" MAIN, WHERE 12" MAIN CROSSES MERIAM Street.

Work completed NEW CORPORATION, CURBBOX

Remarks: .....

.....

.....