


DATE _____

TOWN OF LEXINGTON — BOARD OF PUBLIC WORKS

WATER DIVISION

Sketch of Service Here

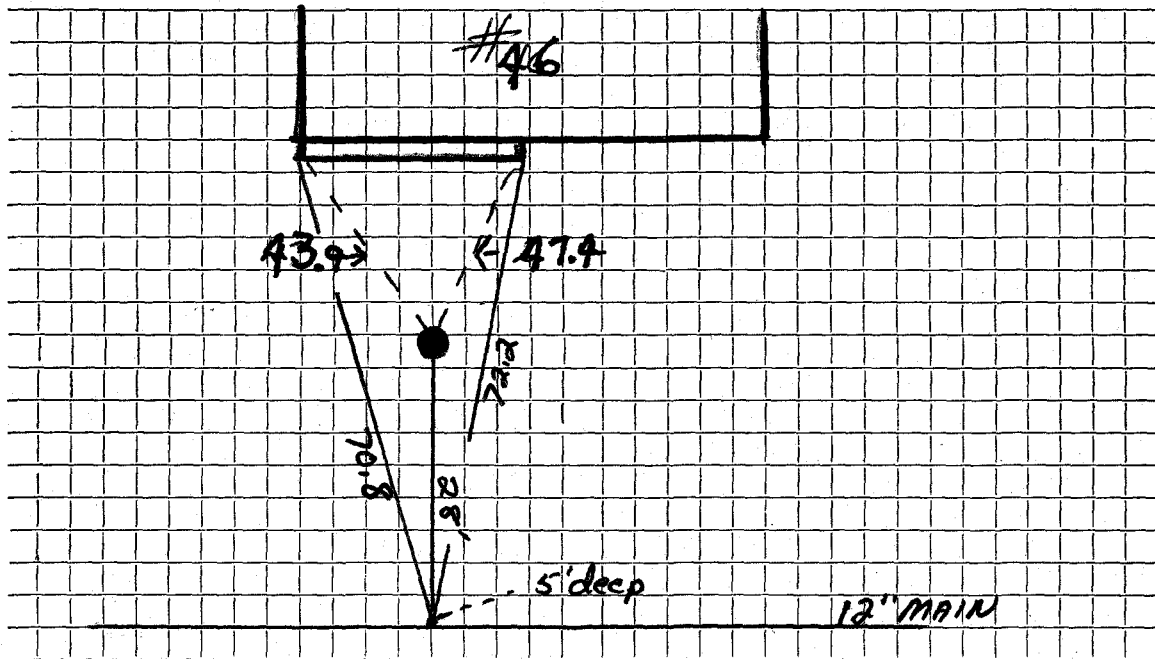

Connection made in Street. Work completed .. 8-25-92

Remarks: 45" Between Curb + 4" Gas Main
6.3" From Gas to Sewer Main
8'10" From Gas to 6" Water Main
Copper goes over Sewer under 6" Water main