




DATE 6-24-1999

TOWN OF LEXINGTON — BOARD OF PUBLIC WORKS  
WATER DIVISION

Sketch of Service Here

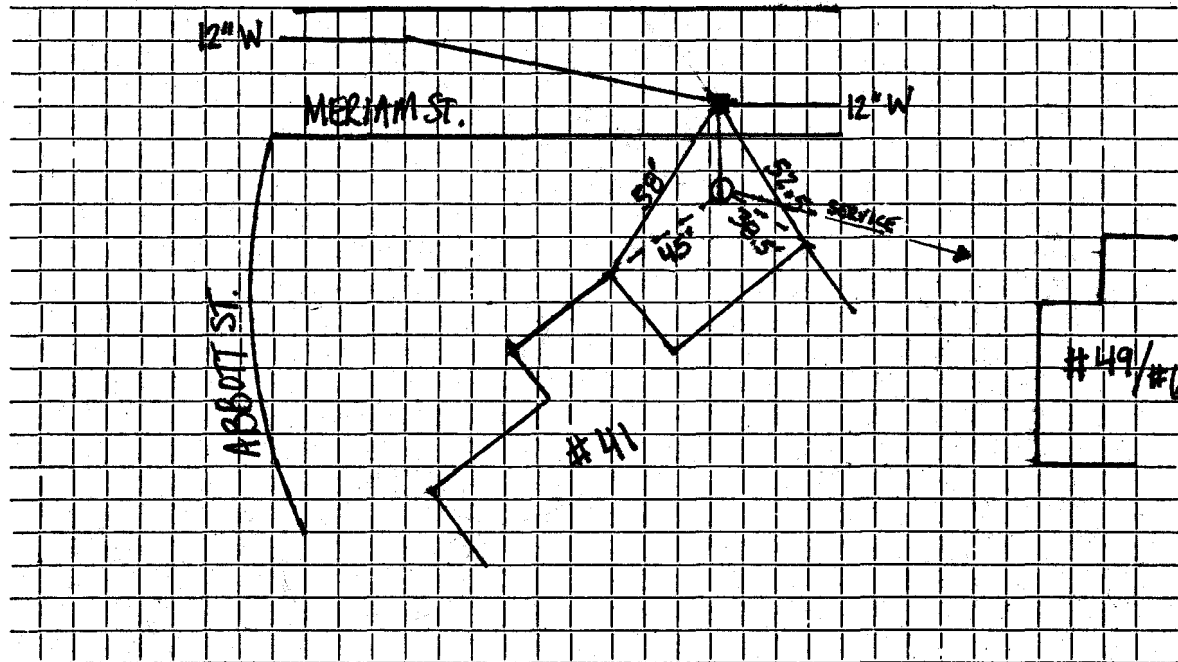

Connection made in 12" MAIN, WHERE 12" MAIN CROSSES MERIAM Street. Work completed NEW CORPORATION, CURB BOX  
Remarks: SERVICE ADJACENT TO # 41 MERIAM ST SERVICE / CORPORATION [7' BTW CORPORATIONS]