

Name

Service No. 1961

Address 50 Meriam St.

Location 50 Meriam St.

Kind of Pipe

Size

Size of Main

Repair—Renewal—New Service

Location

Date

Material

Amount

Total

Date

Amount

11

Labor

TOWN OF LEXINGTON—BOARD OF PUBLIC WORKS

WATER DIVISION

The undersigned applies for a supply of water at No. _____ St. and hereby agrees to comply with the rules and regulations as now, or at any future time, established by the Board of Selectmen.

Am't. of Estimate \$ _____

Owner

H. C. Blake


Am't. Paid \$ _____

Address

off. Meriam St
#50

Builder _____

Sketch of Service Here

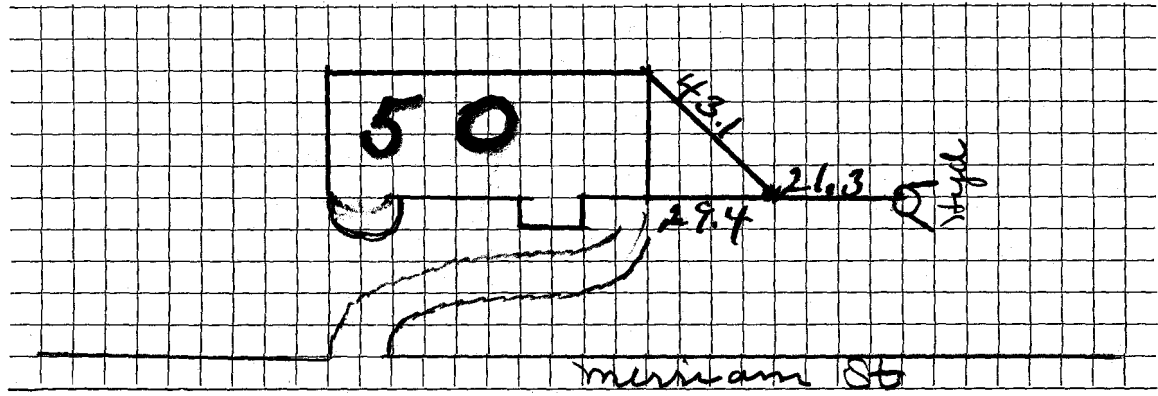

Connection made in _____ Street. Work completed _____ 19

Remarks: