

WATER SERVICE RECORD

Name Gilman W. Haven

Service No. 377

Address 52 Meriam Street

Location

~~Work Renewal~~ - New Service

Committed 4-2-56


Date	Material	Amount	Total	Date	Amount
12/15/55	Labor	13 87		11-23-55 Deposited	\$ 100 00
	10% overhead	1 39	15 26	4-2-56 Refunded	25 26
	90' - 3/4" Copper tubing @ .50		45.00	NON CHARGE	74 74
	4 bags Rock Wool @ 1.75		7 00	12/15/55 Labor	5 55
	1 - 3/4 Union (3 part)		1 77	10' - 3/4" Copper tubing @ .50	5 00
	1 - 3/4Cx $\frac{1}{2}$ I.W.H. Stop & Waste		4 96	1 - 3/4" C. Corp Cock	4 34
	1 hr. trucking		75	1 - 3/4" C. Curb Cock	5 94
			74 74	1 Box & rod	4 62
				1 - $\frac{1}{2}$ Straight tailpiece	50
				1 - $\frac{1}{2}$ Offset tailpiece	50
					26 45

DATE _____

TOWN OF LEXINGTON — BOARD OF PUBLIC WORKS

WATER DIVISION

Sketch of Service Here

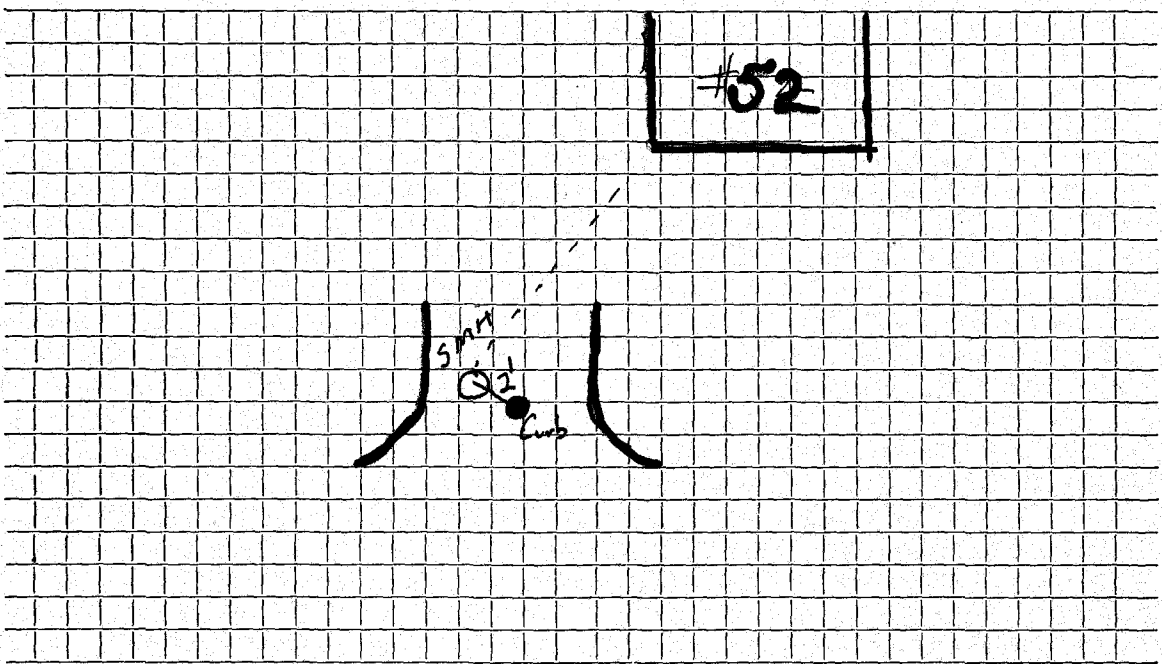

Connection made in Street. Work completed

Remarks:
.....
.....