

WATER SERVICE RECORD

Name BRANKO PISHEV

Service No.

Address #55 MERIAM STREET

Location

Repair—Renewal—New Service

PERMIT NO. 0453 *M. Langford*


Date		Material	Amount	Total	Date	Amount
6/21	95	51'-1"Ø COPPER				
					9-17-60	
					15' 1" Copper	
					1 1" C. Corp Cock	
					1 1" C. Curb Cock	
					1 2" X 1 1/4" L. L. Red. Coup.	
					1 2" X 6" C. I Nipple	
					1 2" S Type 38 Clamp	

DATE 21 JUNE 1995

TOWN OF LEXINGTON — BOARD OF PUBLIC WORKS

WATER DIVISION

Sketch of Service Here

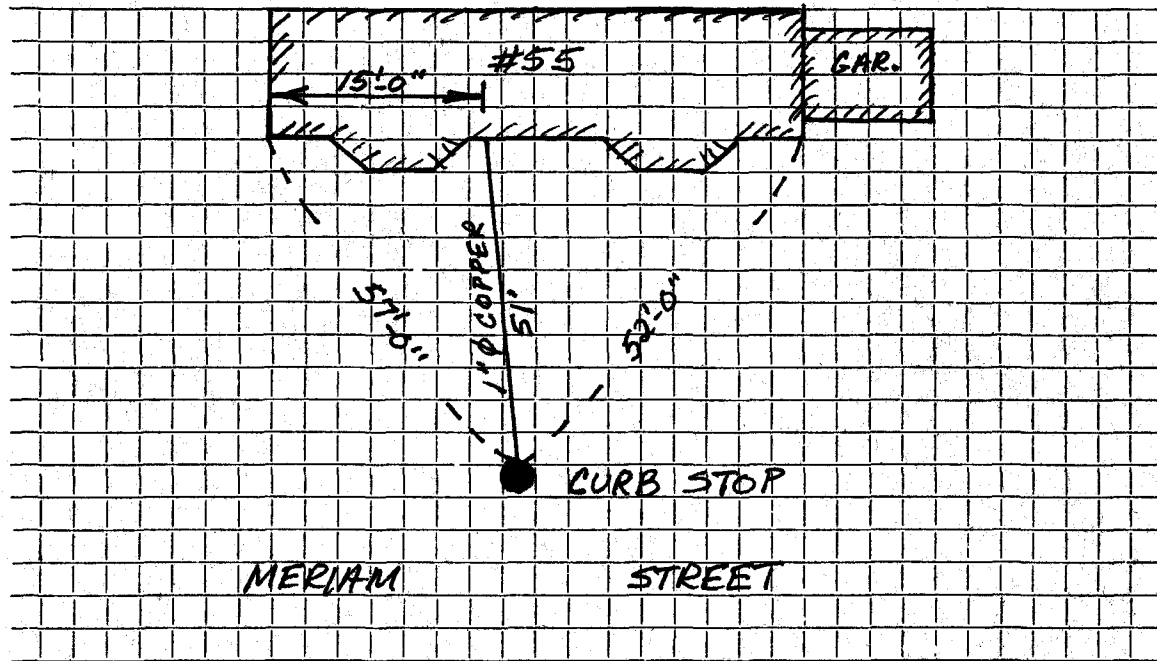

Connection made in MERIAM STREET Street. Work completed J.M. MCLAUGHLIN, INC.

Remarks: .....