

WATER SERVICE RECORD

Name

Service No.

Address

56 MERIAM ST

Location

Repair—

~~Renewal~~ ~~New Service~~

W.O. #567


Date		Material	Amount	Total	Date	Amount
8/9/83	16'	Copper tubing				
		1" 3 Part Union				
		1" Corp.				
		Patch 34' x 12"			10-13-55	
					156'	1" Copper
					2	1" X 1" C. - 3 Part Union
					1	1" C. X 1" I.W.H. Stop + Waste

DATE 8-17-85

TOWN OF LEXINGTON — BOARD OF PUBLIC WORKS

WATER DIVISION

Sketch of Service Here

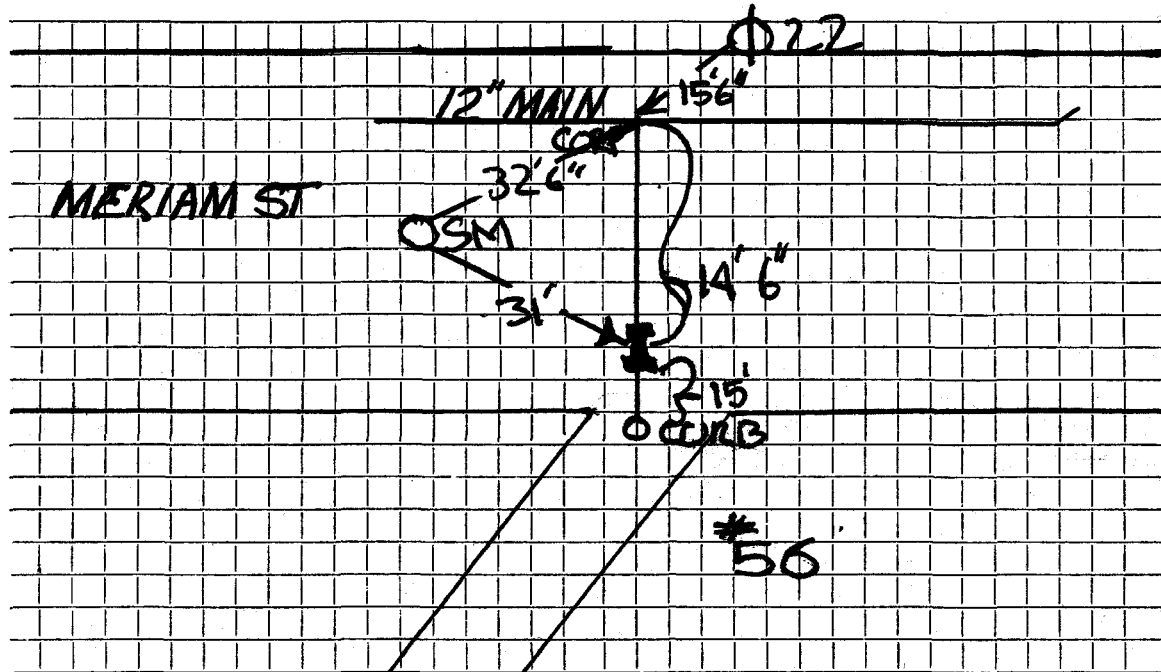

Connection made in ..... Street. Work completed .....

Remarks: .....  
.....  
.....