


TOWN OF LEXINGTON — BOARD OF PUBLIC WORKS

WATER DIVISION

Sketch of Service Here

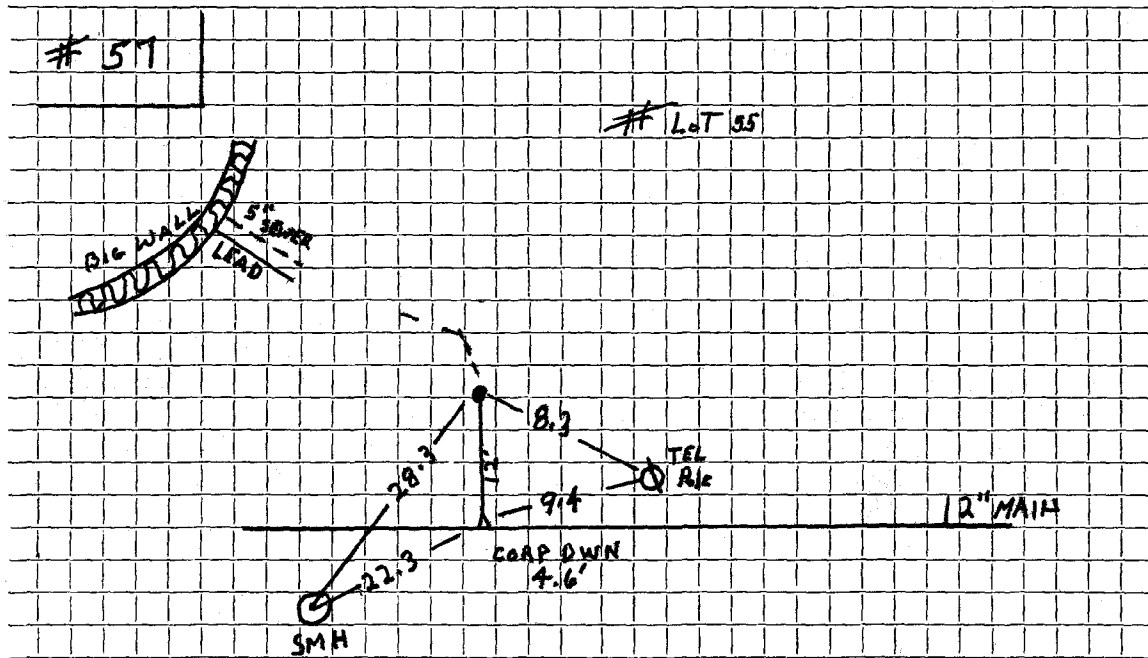

Connection made in MERIAM ST. Street. Work completed

Remarks: 4-1-95. Installation TEST Hole by WALL: LEAD WATER SERVICE.