

DATE August 22, 1938

TOWN OF LYNNINGTON - BOARD OF PUBLIC WORKS WATER DIVISION

The undersigned applies for a supply of water at No. Merriam St. (Garden)
York St. and hereby agrees to
comply with the rules and regulations as now, or at any future time, established by the Board of Selectmen.

Am't. of Estimate \$ 35.00

Owner

Charles M. Blake

Am't. Paid \$ _____


Address

59 York St

Builder _____

Lynnington Mass.

Sketch of Service Here

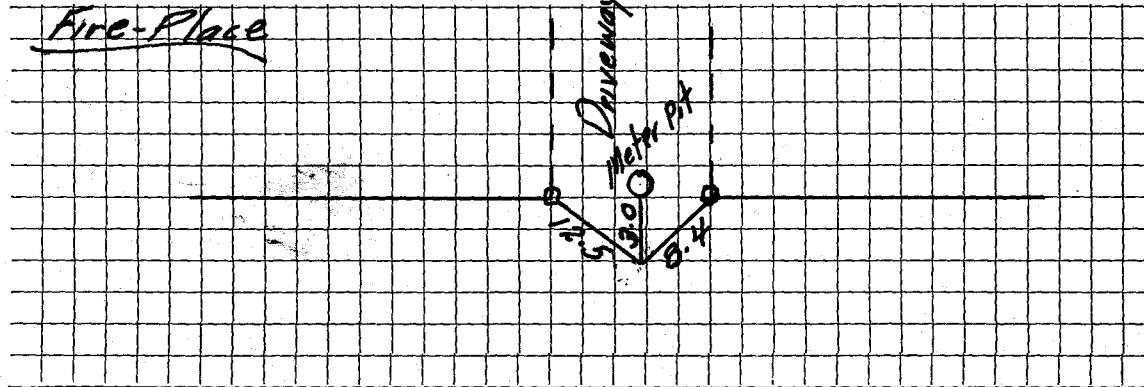

Connection made in _____ Street.

Work completed _____ 19

Remarks: