

WATER SERVICE RECORD

Name

Address 66 MERIAM ST.

Location

Repair—Renewal—**New Service**


Date	Material	Amount	Total	Date		Amount
7/36/92	22.5 LF 1" COPPER					
	1" CORP.					
	1" CURB w/BOX					
	.6"-1" NIPPLE			8-18-58		
	3/8"x1" RED.				12' $\frac{3}{4}$ " Copper	
					1 $\frac{3}{4}$ " C. Corp Cock	
					1 $\frac{3}{4}$ " C. Curb Cock	

DATE _____

TOWN OF LEXINGTON — BOARD OF PUBLIC WORKS

WATER DIVISION

Sketch of Service Here

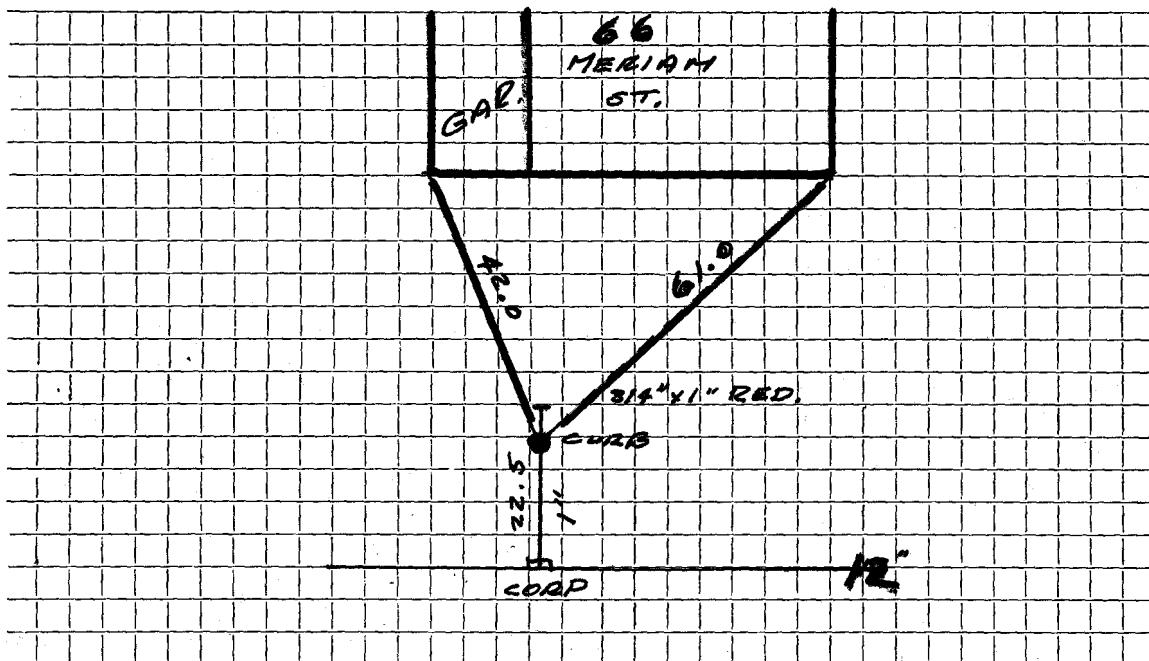

Connection made in MERIDIAN Street. Work completed

Remarks: BISZKO - O.S. CONTR.