

## WATER SERVICE RECORD

Name H.A. McLaughlin

Service No. 196

Address 68 Meriam Street

Location

~~Repair~~ ~~Revised~~ — New Service


Comm. 10-28-57

Date	Material	Amount	Total	Date	Amount
9-18-57	labor	4 01		9-5-57	Deposit \$ 150 00
	10% overhead	40	4 41	10-28-57	Refund 54 07
	152' 3/4" copper tubing @ .375		57 00		NON CHARGE \$ 95 93
	3 3/4" C union 3 part @ 2.27		6 81		Labor 26 83
	1 3/4" x 1/2" IWH stop & waste		4 96	29' - 3/4" Copper tubing @ .375	10 88
	1 hr. trucking		75	1 - 3/4" C. Corp Cock	5 94
	22 x 3 patching		22 00	1 - 3/4" C. Curb Cock	4 64
			95 93	1 Box & Rod	4 62
				1 - 1/2 Straight tailpiece	50
				1 - 1/2 Offset tailpiece	50
				2 hrs. Town Shovel @ 6.50	13 00
					66.91

TOWN OF LEXINGTON — BOARD OF PUBLIC WORKS

WATER DIVISION

Sketch of Service Here

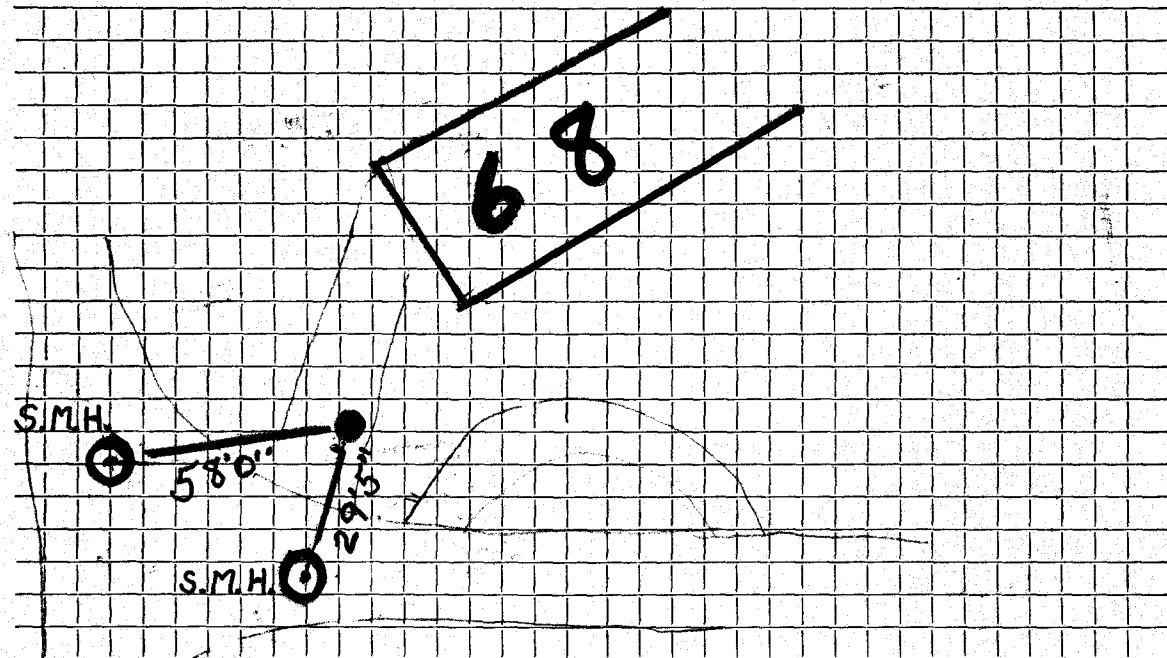

Connection made in *Yard* ..... Street. Work completed .....

Remarks: .....

.....

.....