

WATER SERVICE RECORD

Name Theodore Freeman Jr.

Service No. 61

Address 71 Meriam St. Lexington

Location

Repair—Renewal—New Service WO #3860 Arlex Oil Corp. #2788

Date	Material	Amount	Total	Date	Amount
3/24/76	labor	65. 16			
5/13/76	labor	10. 34			
	10% OH	7. 55	83. 05		
11'	3" copper tubing 3/4" @ .67		8. 04		
1	curb box and rod		15. 35		
1	ton cold patch		13. 70		
1	3/4" curb		13. 70		
1	3/4" corp		10. 53		
2 hr.	shovel @ 6.50		13. 00		
4 hr.	truck @ 3.00		12. 00		
1/2 hr.	compressor @ 5.00		2. 50		
	trench 9 X 7		42. 00		
			213. 87		
3/26/76	63' 3/4" Copper Tubing				

12-4-75
8-16-76

Deposit
Paid by WHP #67


150.00
63.87
213.87

DATE _____

TOWN OF LEXINGTON — BOARD OF PUBLIC WORKS

WATER DIVISION

Sketch of Service Here

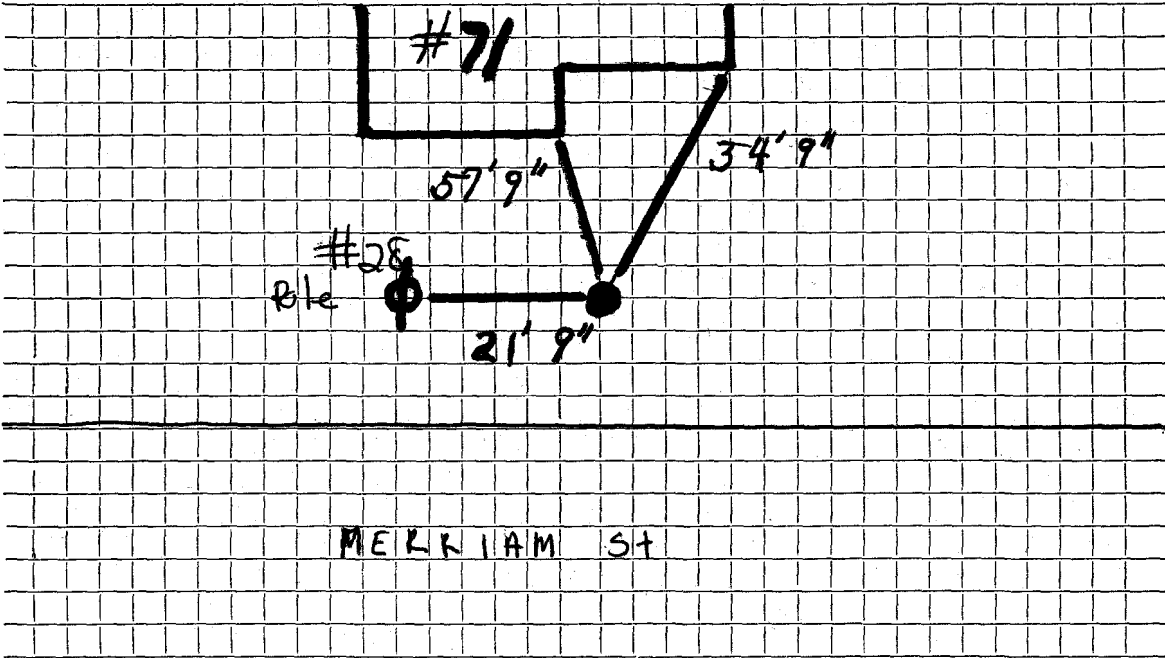

MERRIAM ST

Connection made in Street. Work completed

Remarks:
.....
.....