


DATE SEPT 8 1997

TOWN OF LEXINGTON — BOARD OF PUBLIC WORKS
WATER DIVISION

Sketch of Service Here

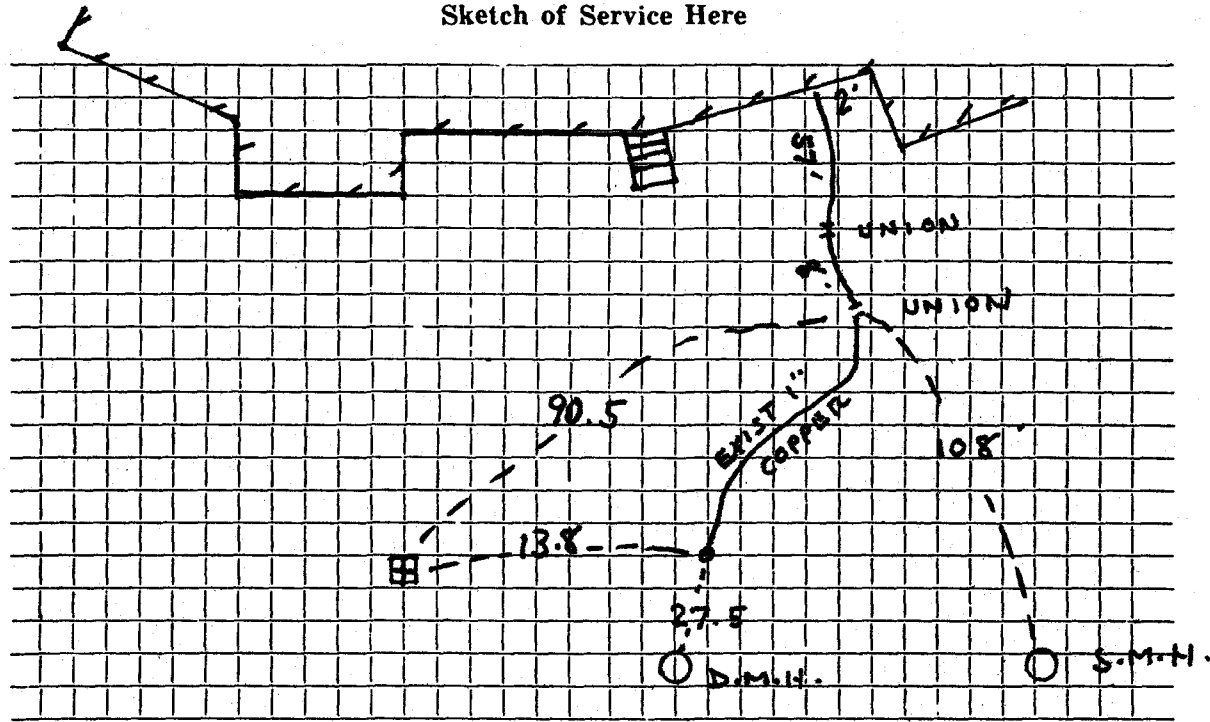

Connection made in 72 MERIAM Street. Work completed J.M. McLAUGHLIN

Remarks:

FIELD BOOK 97-5


TAM

DATE _____

TOWN OF LEXINGTON — BOARD OF PUBLIC WORKS

WATER DIVISION

Sketch of Service Here

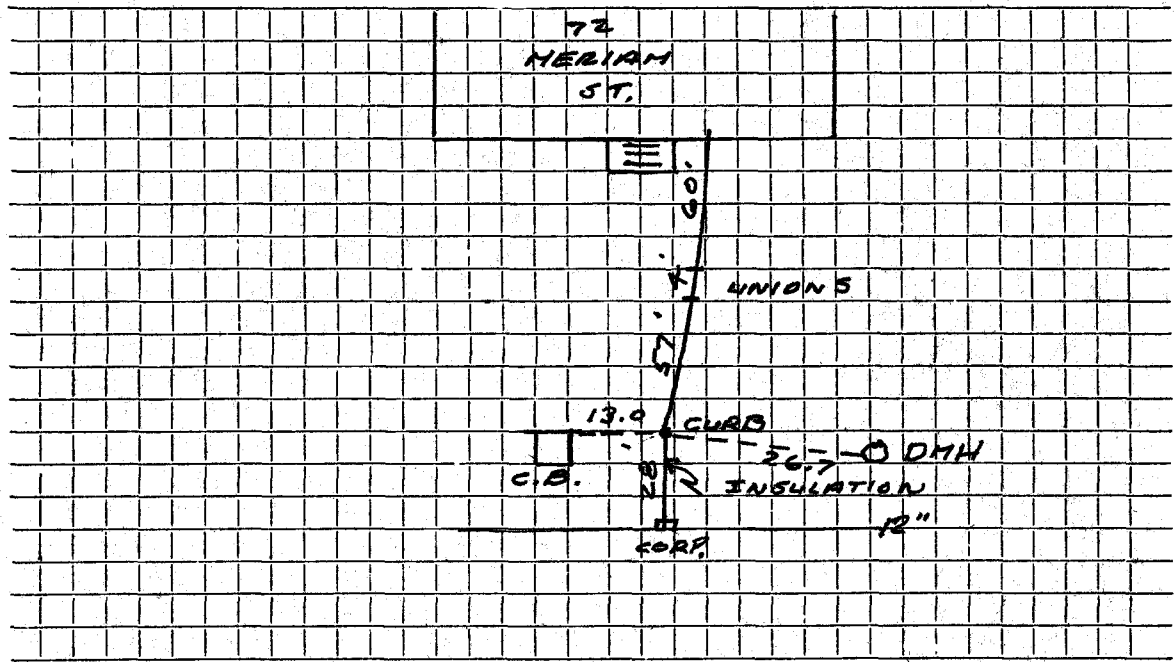

Connection made in MERIAM ST. Street. Work completed

Remarks: ARLEX-INSIDE - Original Service 12-19-52

BISZKO-OUTSIDE