

WATER SERVICE RECORD

Name

Service No.

Address 76 MERIAM ST.

Location


Repair—Renewal—New Service

Date	Outside	Material	Amount	Total	Date	Amount
7/28/92		25 LF 1" COPPER				
		1" COP.				
		1" CURB w/BOX				
		.6" - 1" NIPPLE			8-31-56	Inside
		3/4" X 1" COUPLING			110' 3/4" Copper	
					1 3/4" C. X 1/2" I. W. H. STOP + WASTE	
					1 3/4" C. - 3 PART UNION	

TOWN OF LEXINGTON — BOARD OF PUBLIC WORKS

WATER DIVISION

Sketch of Service Here

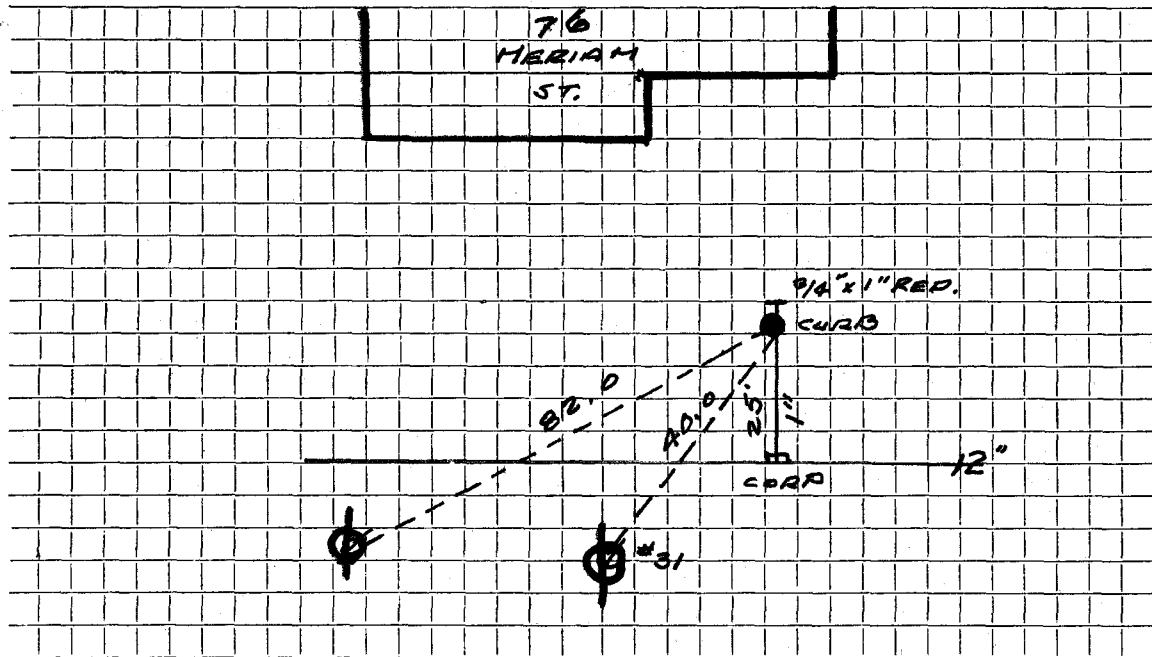

Connection made in MERIAM Street. Work completed

Remarks: BISZIKO - O. S. CONTR.

.....
.....