

WATER SERVICE RECORD **JUL 24 1978**

Name Earl Baldwin

Service No. 4

Address 77 Meriam Street

Location

~~Repair~~—Renewal—~~New Service~~ W.O. #6174


Date	Material	Amount	Total	Date	Amount	
5/16/78	Labor	66.45		5-5-78	Deposit	400.00
	10% O.H.	6.65	73.10	7-24-78	Repair	224.65
42'	3/4" Copper tubing @.83		34.86			155.92
1	3/4" Stop & Waste		17.10		OUTSIDE	
1	3/4" Tail piece		1.00	5/10/17/830	Labor	
1 1/2	yd. Loam @5.44		8.16	16'	3/4" Copper tubing	
5	lbs. Grass Seed @.39		1.95	1	3/4" Corp.	
1/2	Bag Fertilizer		2.25	1	3/4" Curb	
1/2	Bag Lime @3.00		1.50	6	yds. Gravel	
1	hr. Trucking		3.00	3	ton Cold Patch	
2	hrs. Backhoe @6.50		13.00		Patch 15 x 10	
			155.92		Patch 6 x 16	

DATE \_\_\_\_\_

# TOWN OF LEXINGTON — BOARD OF PUBLIC WORKS

## WATER DIVISION

Sketch of Service Here

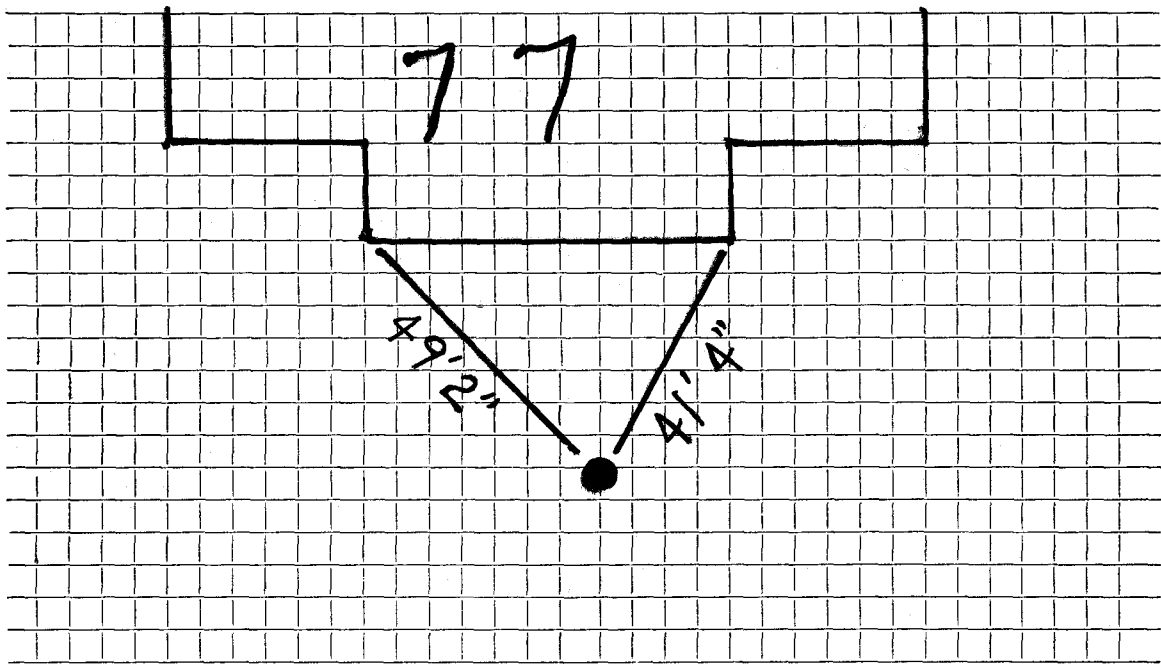

Connection made in ..... Street. Work completed .....

Remarks: .....  
.....  
.....