


Water Service Tie Card
TOWN OF LEXINGTON
 MASSACHUSETTS

83 Meriam St

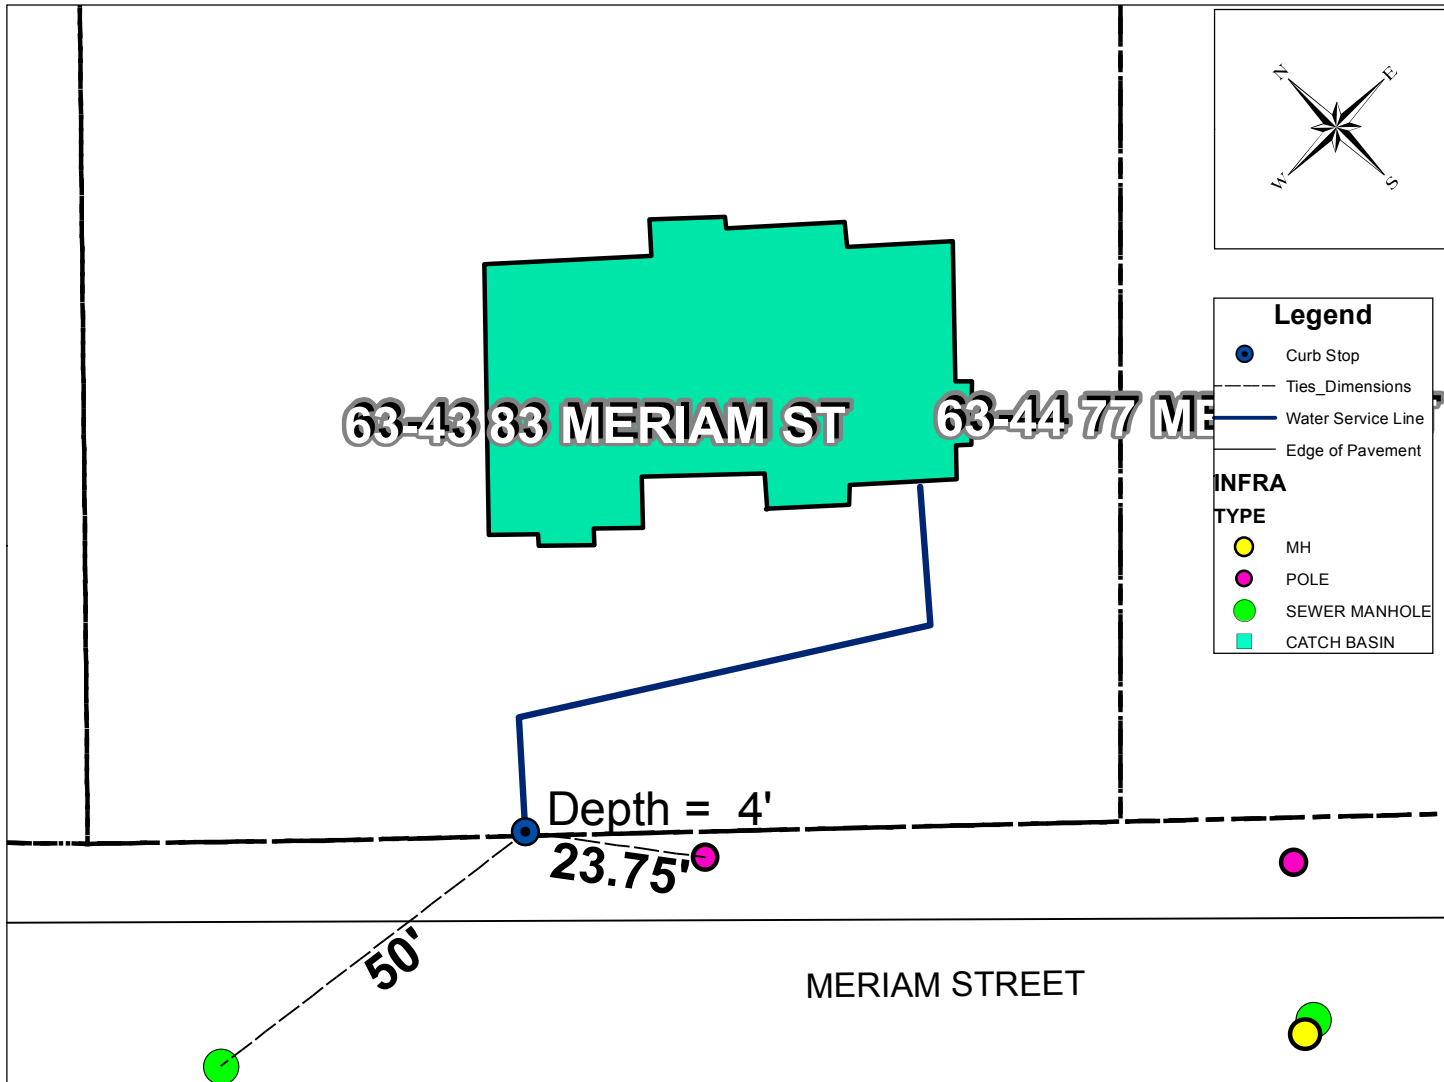

Address	Map and Lot	Permit Number	Contractor Name	Inspector
83 Meriam	63-43	6341	Arlex Oil Corporation	msprague
Date	Material	Depth of Cover	Amount	
9/17/2015	1" Curb Valve and Buffalo Box	4 ft	1	
	1" Copper type "k"	4 ft	87 ft to HSE	
Type of work completed				

New 1" water service to house from curb stop. New house on lot old house removed.