


DATE _____

TOWN OF LEXINGTON — BOARD OF PUBLIC WORKS

WATER DIVISION

Sketch of Service Here

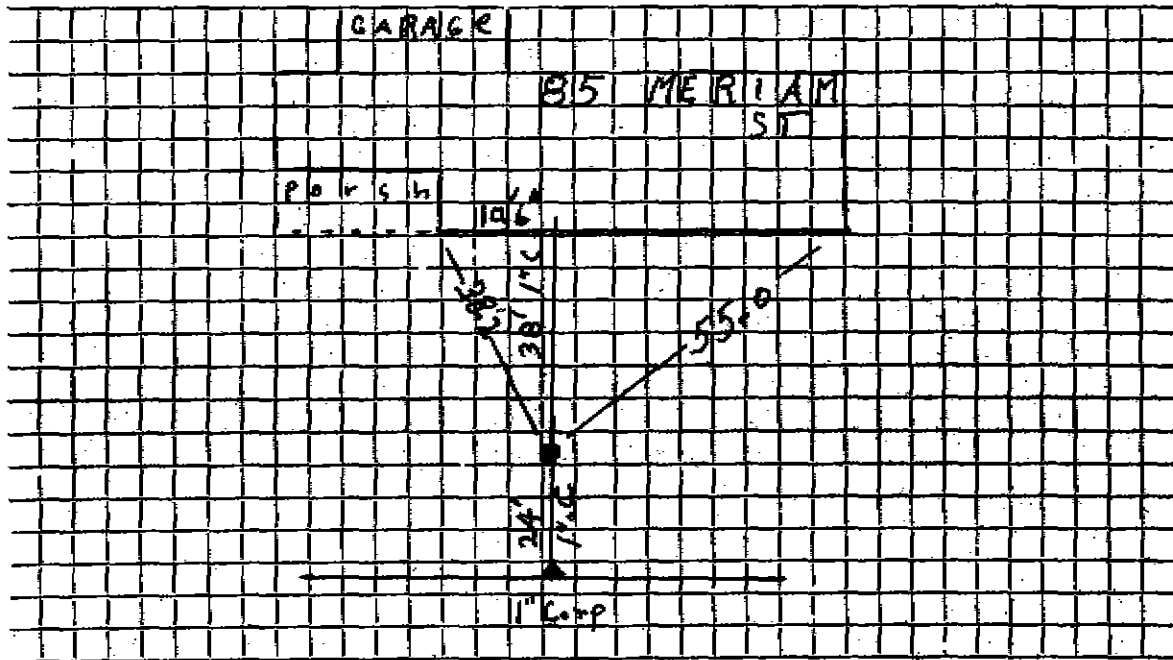

Connection made in Street. Work completed 9/10/08 J. McClaw

Remarks: CONT ST TO PROP. BIZZCO 1992