

WATER SERVICE RECORD

Name Jerrold H. VanHook

Service No. 112

Address 89 Meriam Street

Location

Renewal

~~Renewal~~ ~~New Service~~ W.O. #1172

MAY 2 1966


Date	Material	Amount	Total	Date	Amount
11-3-65	Labor	90.32		11-3-65	200.00
	10% C.H.	9.03	99.35	12-44	30.36
60'	3/4" Copper tubing @70		42.00		169.64
1	3/4" W.H. Stop & Waste		9.29		
2	hrs. Town Shovel @6.50		13.00	11-3-65	Labor 39.15
2	hrs. Trucking @3.00		6.00	3-29-66	" 43.34
			169.64		
				26'	3/4" Copper tubing @.70
				1	3/4" C Curb Cock
				1	hrs. Town Shovel @6.50
				1	hr. Compressor @5.00
				1	hr. Roller @3.00
				1	hr. Trailer
				2	hrs. Trucking @3.00
				2 1/2	ton Hot Top @5.50
				1	ton Cold Patch
					150.70

DATE _____

TOWN OF LEXINGTON — BOARD OF PUBLIC WORKS

WATER DIVISION

Sketch of Service Here

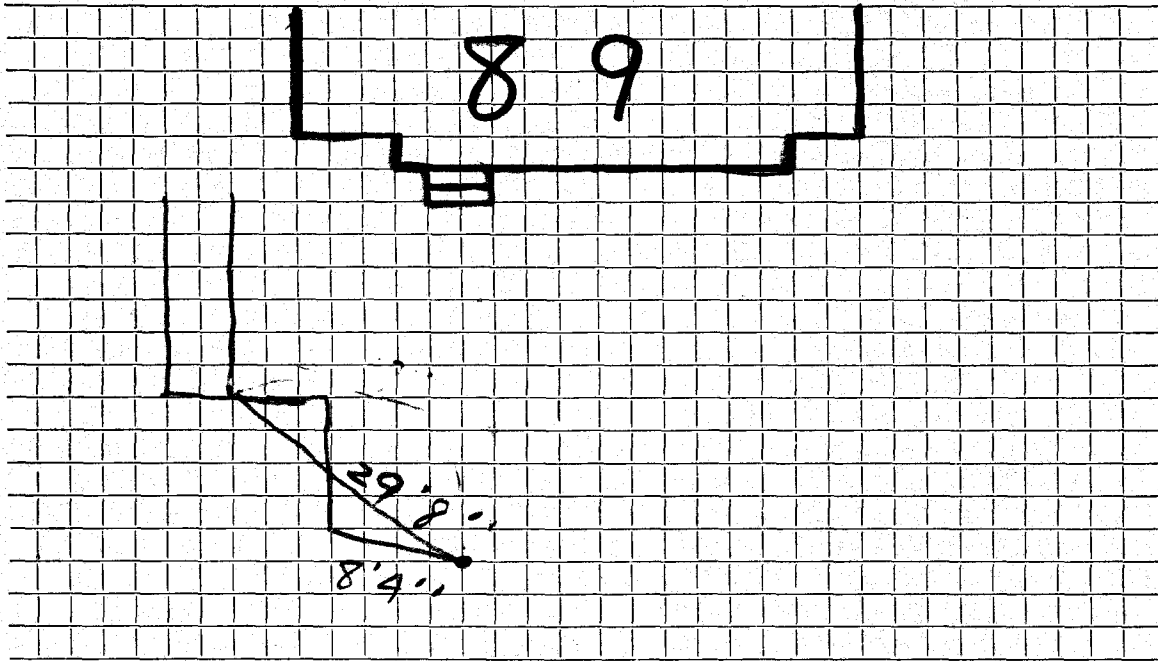

Connection made in Street. Work completed

Remarks:
.....
.....