

WATER SERVICE RECORD

Name Moore Homes, Inc.

Service No. 60

Address 9 Meriam Street

#9 Meriam St.

Location

#7792

Repair—Renewal—New Service DeFlice #A414 W.D #3099

Sept 5, 1967

Date		Material	Amount	Total	Date	Amount
9-28-66	5.5'	2" Copper tubing			7-46	100 00
9-26-66		Labor	30.09		9-5-67	21 15
		10% O.H.	3.01	33.10		121 15
	12"	2" Copper tubing		2.51		
	1	2" Curb Cock		42.76		
	1	2" Corp Cock		30.18		
	1	Box & Rod		5.10		
	2½	hrs. Trucking		7.50		
				121.15		

Deposit


Paid by SHC #112

DATE _____

TOWN OF LEXINGTON — BOARD OF PUBLIC WORKS

WATER DIVISION

Sketch of Service Here

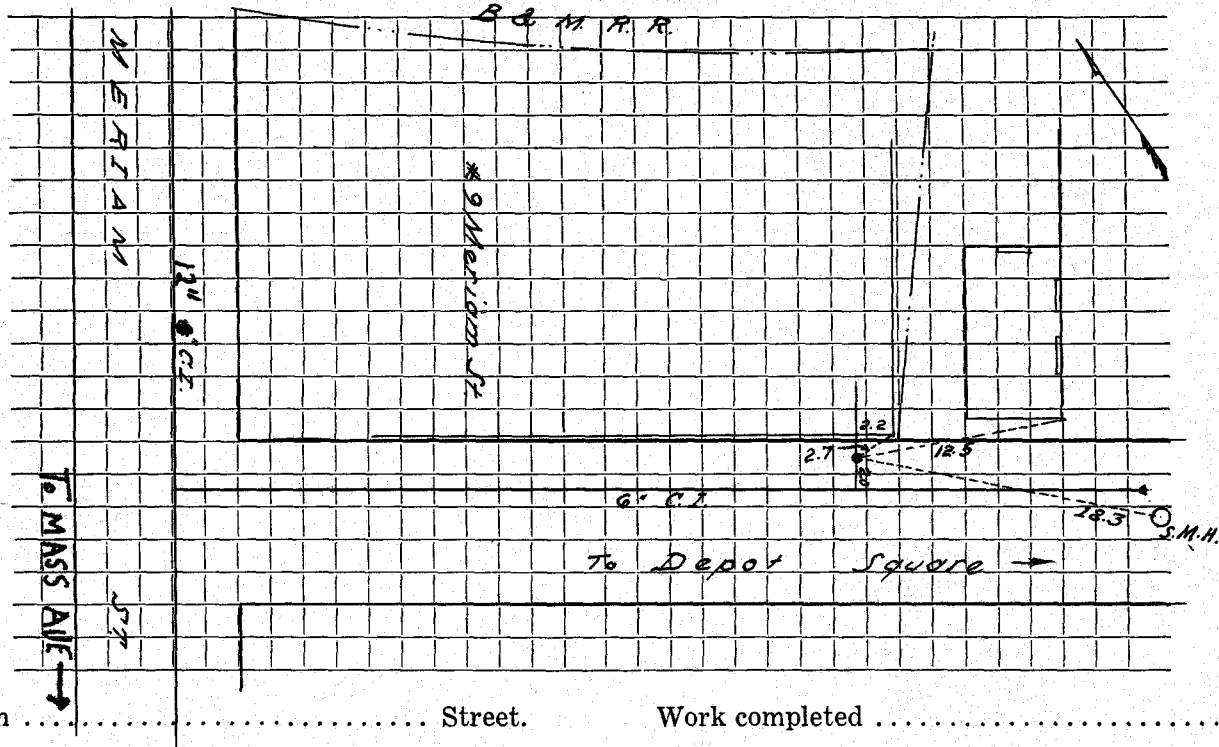

Connection made in Street. Work completed

Remarks:
.....
.....