

WATER SERVICE RECORD

Name

Service No.

Address 95 MERIAM ST.

Location

Repair—Renewal—New Service


| Date | Material | Amount | Total | Date | Amount |
|---------|---|--------|-------|---------------------|--------|
| 7/20/92 | 21 LF 1" COPPER 1" CORP. 1" CURB W/BOX .6" - 1" NIPPLE 3/4" x 1" RED. | | | | |
| | | | | 9-26-'84 | |
| | | | | <u>Inside</u> | |
| | | | | 6 1/6" 3/4" Copper | |
| | | | | 1 3/4" Wheel handle | |

DATE _____

TOWN OF LEXINGTON — BOARD OF PUBLIC WORKS

WATER DIVISION

Sketch of Service Here

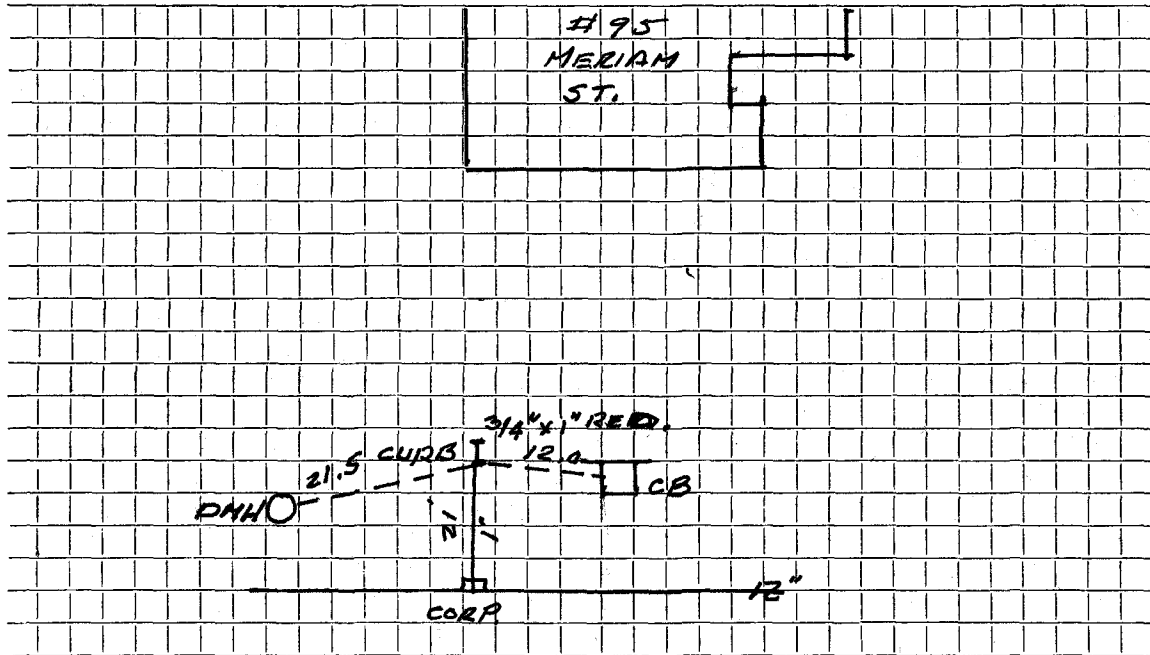

Connection made in MERIAM Street. Work completed

Remarks: BISZKO - O. S. CONTR.