




TOWN OF LEXINGTON — BOARD OF PUBLIC WORKS

WATER DIVISION

Sketch of Service Here

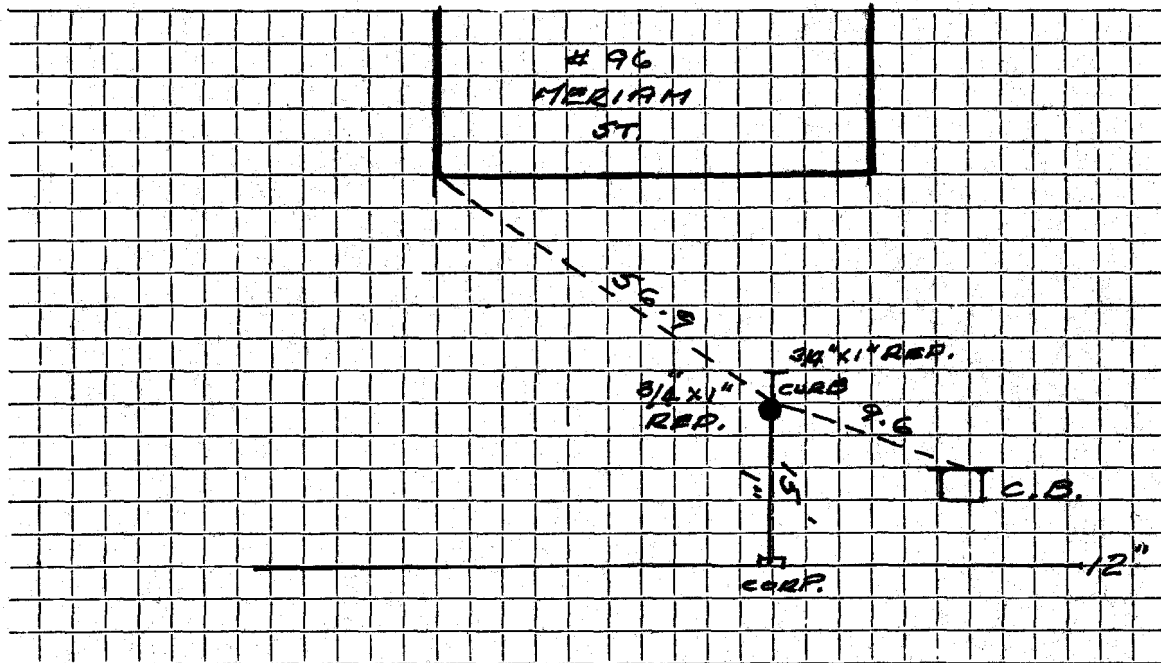

Connection made in MERIAM Street. Work completed .....

Remarks: BISZKO - O. S. CONTR. - Original Service 7-21-37' .....