

WATER SERVICE RECORD

Name Richard F. Magnuson

Service No. 62

Address 97 Meriam Street

Location

~~REPAIR~~—Renewal—~~NEW SERVICE~~ W. O. #5084

MAY 9 1977


Date	Material	Amount	Total	Date	Amount
11/16/76	Labor	74.98			
	10% O.H.	7.50	82.48	11-12-76	Deposit
	60' 3/4" Copper tubing @.65		39.00	5-9-77	Retained
1	3/4" Wheelhandle		14.53		OUTSIDE
1	Offset tail piece		1.00	11-18-76	Labor
1	hr. Trucking @ \$3.00		3.00	12-1-76	"
1	hr. Town Shovel @ \$6.50		6.50		24' 3/4" Copper @.65
			146.51		1 3/4" Corporation
					1 3/4" Curb Cock
					1 ton Cold Patch
					13' x 13' x 3"
					3 1/2 hrs. Trucking @ \$3.00
					1 hr. Roller @ \$2.00
					2 hrs. Town Shovel @ \$6.50
					2 hrs. Compressor @ \$5.00
					1 hr. Loader @ \$4.00
					4.00
					433.13

DATE _____

TOWN OF LEXINGTON — BOARD OF PUBLIC WORKS

WATER DIVISION

Sketch of Service Here

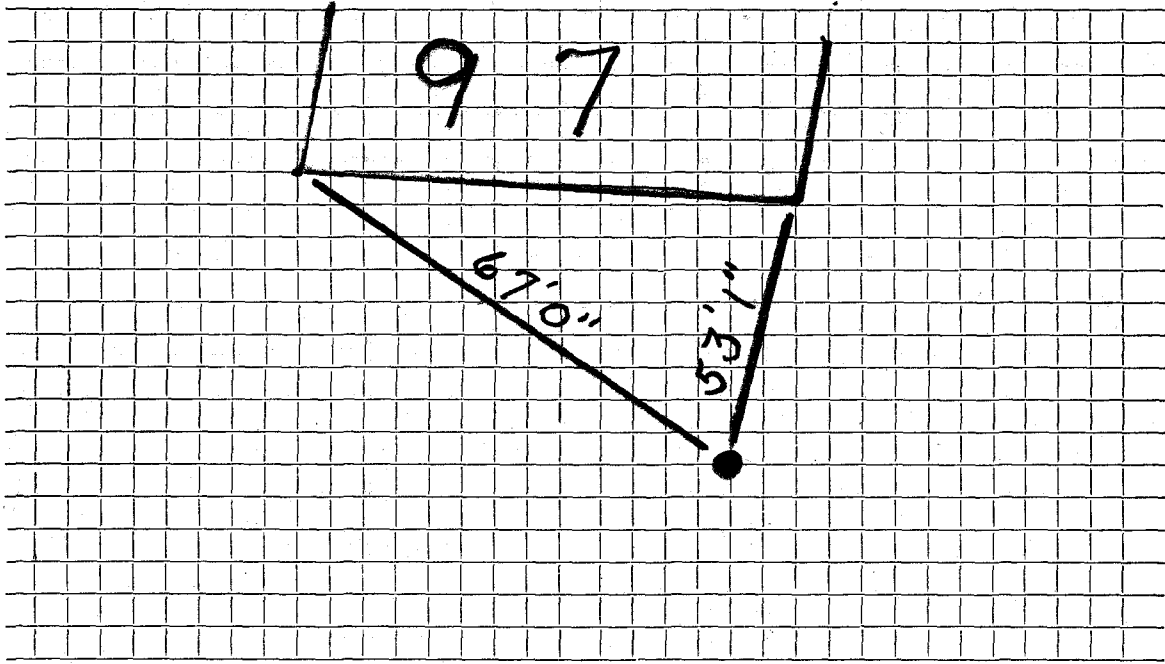

Connection made in Street. Work completed

Remarks:
.....
.....