

## WATER SERVICE RECORD

Name Grace V. White

Service No. 33

Address 12 Middle Street

Location

~~Repair~~ ~~Renewal~~ ~~New Service~~ WO # 4655

OCT 25 1976


Date	Material	Amount	Total	Date	Amount	
6/30/76	labor	94. 50		6-30-76	Deposit	285.00
	10%OH	9. 50	104. 00	10-25-76	Refund	114.92
46'	3/4" Copper @ .65		29. 90			178.08
1	3/4 X 3/4 stop & waste		14. 53		OUTSIDE	
1	3/4 X 3/4 F-adaptor		1. 27	6/25/76	labor	75. 32
1	3/4 X 3/4 elbow		. 79	20'	3/4" copper @ .65	13. 00
1	3/4" close nipple		1. 40	1	3/4" corporation	10. 53
1	yd. loam		2. 19	1	3/4" curb	13. 70
2	hr. shovel @ 6.50		13. 00	1	3/4" iron <del>xxxx</del> clamp	5. 20
1	hr. trucking @ 3.00		3. 00	1	box and rod	15. 40
			170. 08	1	iron nipple	1. 40
				1/2	hr. trucking @ 3.00	1. 50
				2	hr. shovel @ 6.50	13. 00
				1 1/2	ton hot top 18' X 4'2" X 3"	48. 00
						197. 05

DATE \_\_\_\_\_

TOWN OF LEXINGTON — BOARD OF PUBLIC WORKS

**WATER DIVISION**

Sketch of Service Here

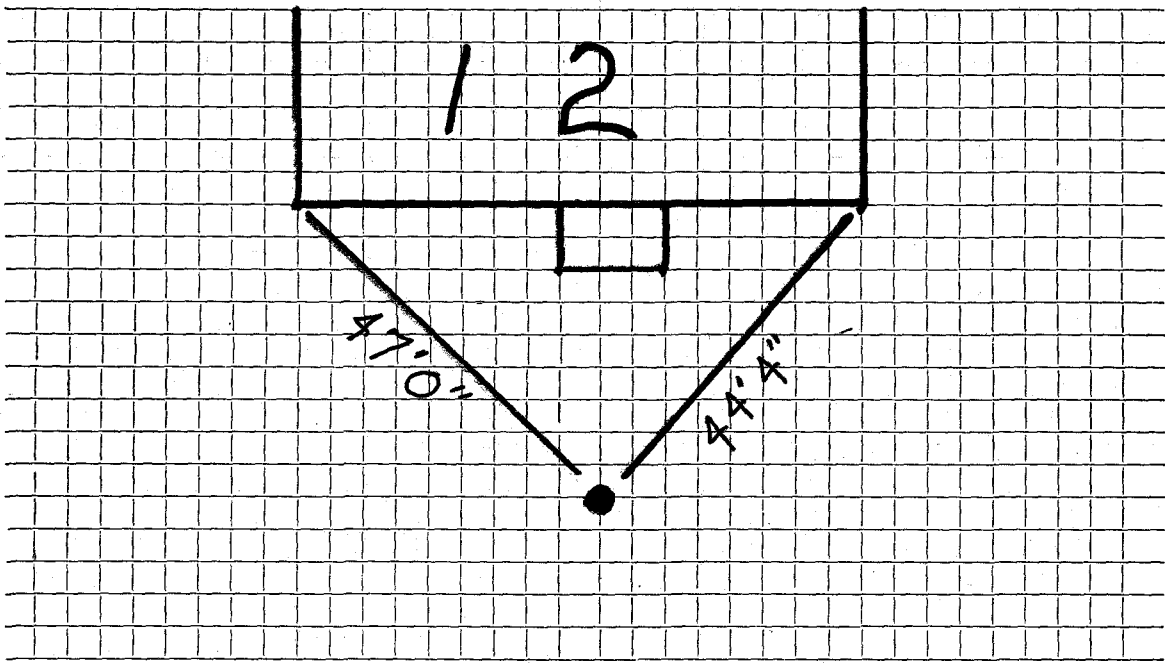

Connection made in ..... Street. Work completed .....

Remarks: *Original Service 4-27-27* .....

.....  
.....