
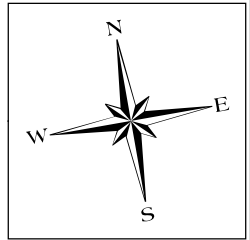


Water Service Tie Card
TOWN OF LEXINGTON
 MASSACHUSETTS

14 Middle Street

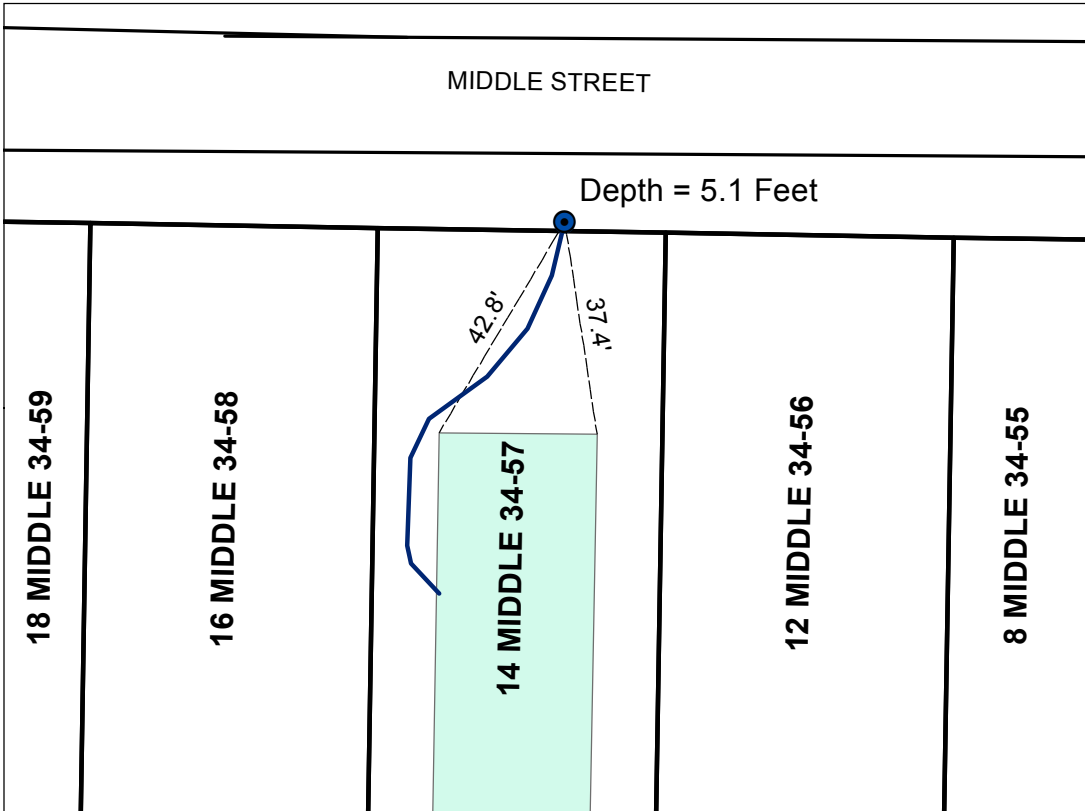

Legend

- Curb Stop
- Water Service Line
- - - Ties_Dimensions

Address	Map and Lot	Permit Number	Contractor Name	Inspector
14 Middle Street	34 -57	5511	McLaughlin	D. Pavlik

Date	Material	Amount
January 13, 2014	3/4" Copper	6 inches off of existing curb stop
	1" x 3/4" fitting	
	1" Copper	6 inches
	1" Curb Stop	
	1" Copper type "k"	77 Feet

Type of work completed

New 1" water service to house from curb stop. New house built - old house removed on existing lot.