

WATER SERVICE RECORD

#609

Name **Jojen Realty Trust**

Service No. 55

Address **17 Middle Street**

Location

~~XXXXXXXXXXXX~~ **New Service** W.O. # 9204 **Eagle #1819**

Comm 4-20-71


Date		Material	Amount	Total		Date	Amount
12/4/70		Labor		13	76	<i>11-24-70</i>	<i>Deposit</i> 80 00
		10% O.H.		1	38	<i>4-20-71</i>	<i>Retrad</i> 37 97
	10'	3/4" Copper pipe	.79	7	90		52 03
	1	3/4" Curb Stop		11	32		
	1	3/4" Corporation		9	50		
	1	Box & Rod		5	10		
	1	Hr. Trucking		3	00		
				52	03		
4-1-71	37.5'	3/4" Copper tubing					

DATE _____

TOWN OF LEXINGTON — BOARD OF PUBLIC WORKS

WATER DIVISION

Sketch of Service Here

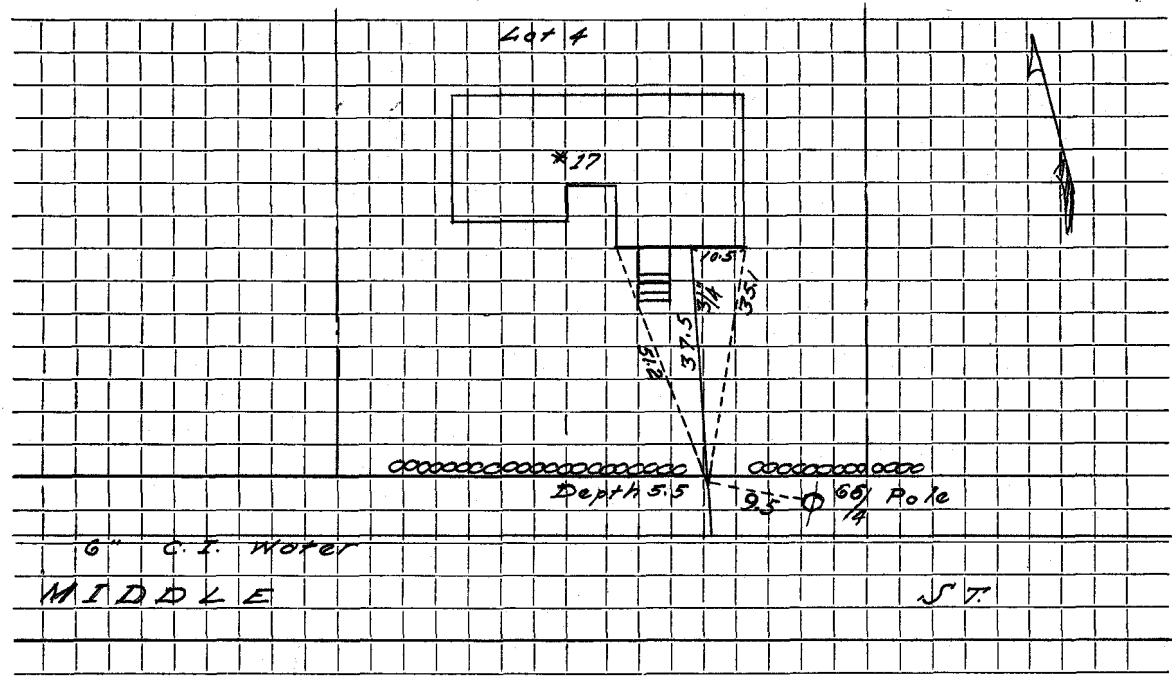

Connection made in Street. Work completed

Remarks:
.....
.....