

WATER SERVICE RECORD

3142

Name M. P. Scott

Service No. 5

Address 18 Middle Street

Location

~~Repair~~ - Renewal - New Service W.O. 6352


Date	Material	Amount	Total	Date	Amount
4/4/68	Labor	64 32		3-25-68	200 00
	10% O.H.	6 43	70 75	8-5-68	59 44
	42' 3/4" copper pipe @ .79		33 18		140 56
	1 3/4" + 3/4" Wheel handle stop & waste		11 13	11-4-52	
	3 hrs. shovel @ 6.50		19 50	30' 3/4" Copper	
	2 hrs. trucking @ 3.00		6 00	1 3/4" C. Adapter	
	TOTAL COST		\$140 56	1 3/4" C. X 3/4" C. Curb Cock	
				1 Box + Rod	

DATE _____

TOWN OF LEXINGTON — BOARD OF PUBLIC WORKS

WATER DIVISION

Sketch of Service Here

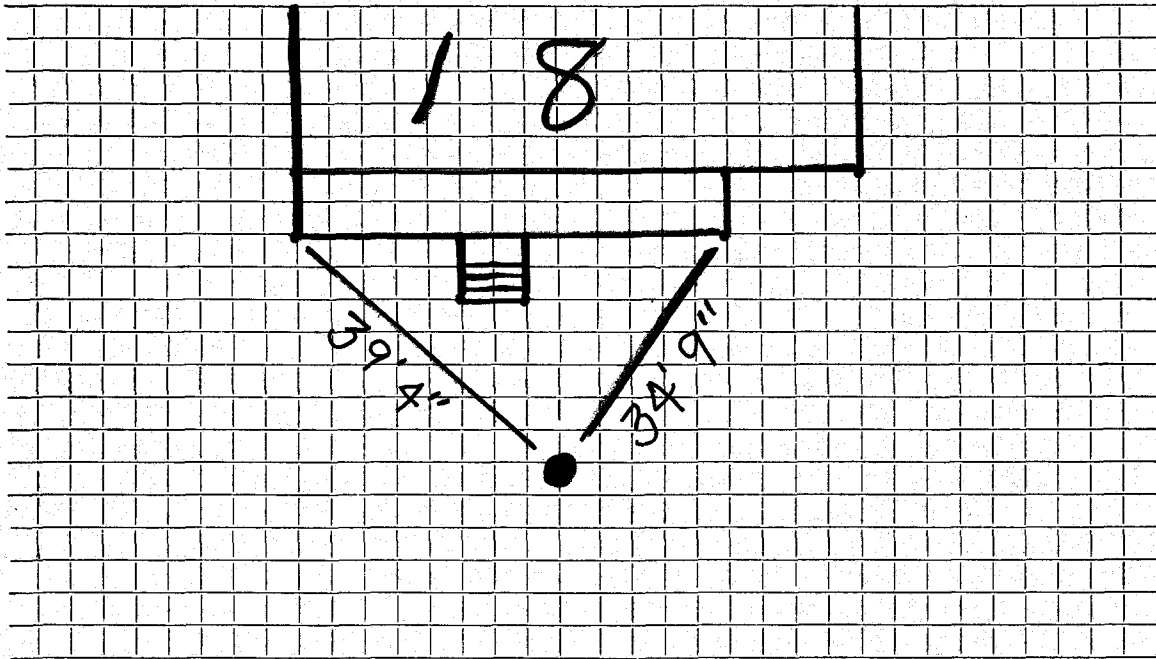

Connection made in Street. Work completed

Remarks: *Original Service 6-10-'26'*

.....
.....