

Name William Crocker, Owner

Service No. ~~88~~ 1984

Address Lot #155, Middle St.

22 Middle St.

Builder: Martin Manzelli, (Pays for service)  
 Location 1016 Belmont St., Belmont

Kind of Pipe

Size

Size of Main

~~Repair-Renewal~~ - New Service

Location

Date	Material	Amount	Total	Date	Amount
P. 12-31-31 for 27.75	35' $\frac{5}{8}$ " Copper Pipe	7 00			
	1 $\frac{5}{8}$ " x 1" C. & O. I. Ell	80			
	1 S & W	3 00			
	Trucking	75	11 55		
11/25/31	7 Hrs. Labor @ .55	3 85			
	3 " " @ .60	1 80	5 65		
	15% Overhead		85		
	<b>COST</b>		18 05		
	<b>CHARGE</b> 35' @ .75	\$26 25	26 25		
	Jan 12 1932 - Refund		1 50		
	Labor		27 75	Nov. 21 1931 - Cash	27 75

Cress, Inc., Lexington  
 (dley)

37  
75  
185  
259  
272.75

DATE Nov. 21, 1931

# TOWN OF LEXINGTON—BOARD OF PUBLIC WORKS

## WATER DIVISION

(Lot 155)

The undersigned applies for a supply of water at No. #22 Middle St. and hereby agrees to comply with the rules and regulations as now, or at any future time, established by the Board of Selectmen.

Am't. of Estimate \$ \_\_\_\_\_

Owner

William Crocker

Am't. Paid \$ \_\_\_\_\_


Address

171. albton st.

Builder (1016) Martin Manzelli Belmont St Belmont.

Cambridge

Sketch of Service Here

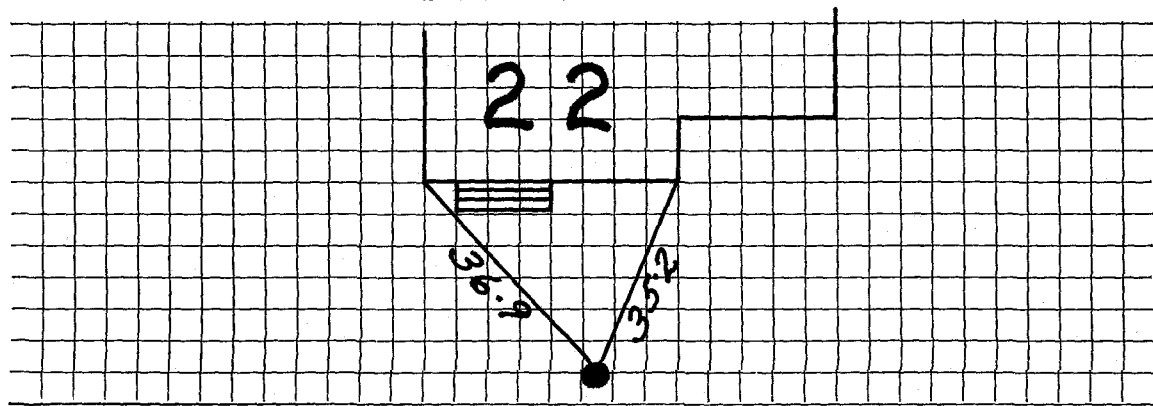

Connection made in \_\_\_\_\_ Street.

Work completed \_\_\_\_\_ 19

Remarks: