

WATER SERVICE RECORD

Name Mrs. Frank Napoli

Service No. 87

Address 23 Middle Street

Location

~~Repair~~ ~~Renewal~~ ~~New Service~~
~~XXXXXX~~ ~~XXXXXX~~ ~~XXXXXX~~


Date	Material	Amount	Total	Date	Amount
6-7-58	Labor	114.50		3-14-59	Deposit
	10% O.H.	11.45	125.95	1-7-59	Paid
	62' 1" Copper tubing @.5202		32.25		
1	1" C x 1" I.W.H. Stop & Waste		6.59		NON CHARGE
1	1" C 3 part union		3.76	6-7-58	Labor
1	1" C 2 part union		1.97		7' 1" Copper tubing @.5202
3	hrs. Town Shovel @6.50		19.50		1 1" C Corp Cock
2	hrs. Trucking @.75		1.50		1 1" C Curb Cock
			191.52		1 Box & Rod
					1 1" Offset tailpiece
					1 1" Straight tailpiece
					6 x 3 Patch
					1 hr. Town Shovel @ 6.50
					1 hr. Trucking @.75
					97.91

Billson 11-17-58 66.52

DATE _____

TOWN OF LEXINGTON — BOARD OF PUBLIC WORKS
WATER DIVISION

Sketch of Service Here

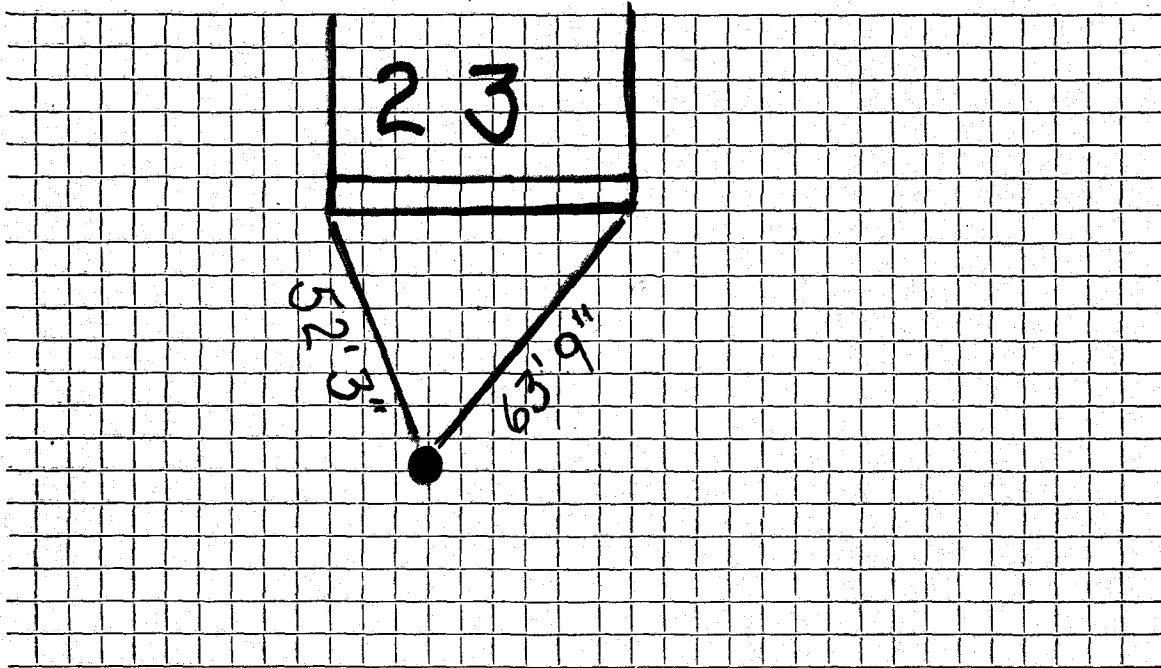

Connection made in Street. Work completed

Remarks:

.....

.....