

WATER SERVICE RECORD

Name John Anderson

Service No. 30

Address 28 Middle Street

Location

~~Repair/Reconnect~~ New Service

Conn. 3-22-54

Date	Material	Amount	Total	Date	Amount
3/4/54	Labor	1 75		2-23-54	Deposited 25 00
	10% overhead	18	1 93	3-22-54	* Refunded (3 80)
	40' - 3/4" copper tubing@.3629	14 52			<u>NON CHARGE</u> 21 20
	1 -3/4"C x 1/2 I.W.H. stop & waste	4 00		3/4/54	Labor 1 75
	1 hr. trucking		75		
			21 20	22' - 3/4" copper tubing@.3629	7 98
				1 - 3/4"C. corp-cock	4 33
				1 -3/4"C. x 3/4"C. curb-cock	4 67
				1 box and rod	3 90
				1 -1/2straight tail pc.	50
				1 -1/2offset tail pc.	50
				1 hr. trucking	75
					<u>24 38</u>


* \$1.86 made payable to town
 apply on bal. due on
 S. D. C. # 7

DATE _____

TOWN OF LEXINGTON — BOARD OF PUBLIC WORKS

WATER DIVISION

Sketch of Service Here

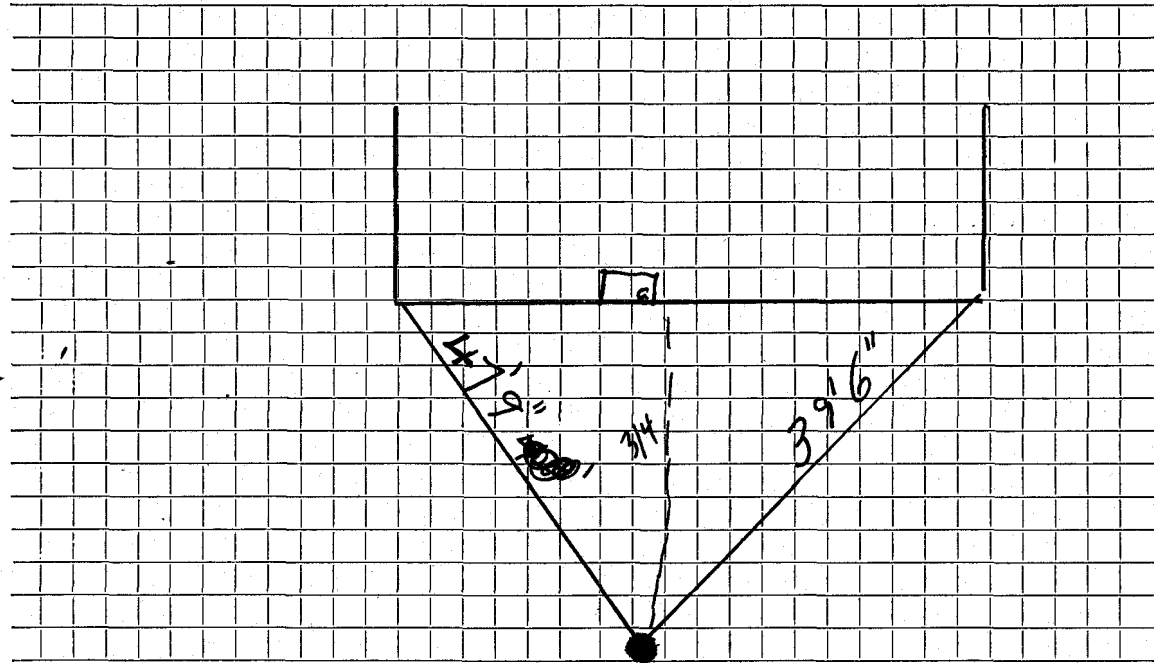

Connection made in Street. Work completed

Remarks:
.....
.....