

WATER SERVICE RECORD

Name Leo W. Kritsick

Service No. 21

Address 3 Middle Street

Location

~~Repair Charge~~—New Service

Valeri permit #2081

AUG 14 1972


Date	Material	Amount	Total	Date	Amount
				5-4-72	26.00
					<i>Deposit</i>
					<u>NON-CHARGE</u>
				5/12/54	Labor 1.85
6/2/72	77' 3/4" Copper			30' - 3/4" Copper tubing @ .35	10.50
				1 - 3/4" C. Corp-cock	4.33
				1 - 3/4" C x 3/4" C. Curb-cock	4.67
				1 - Box & Rod	3.90
				1 hr. Trucking	.75
					<u>26.00</u>

DATE _____

TOWN OF LEXINGTON — BOARD OF PUBLIC WORKS

WATER DIVISION

Sketch of Service Here

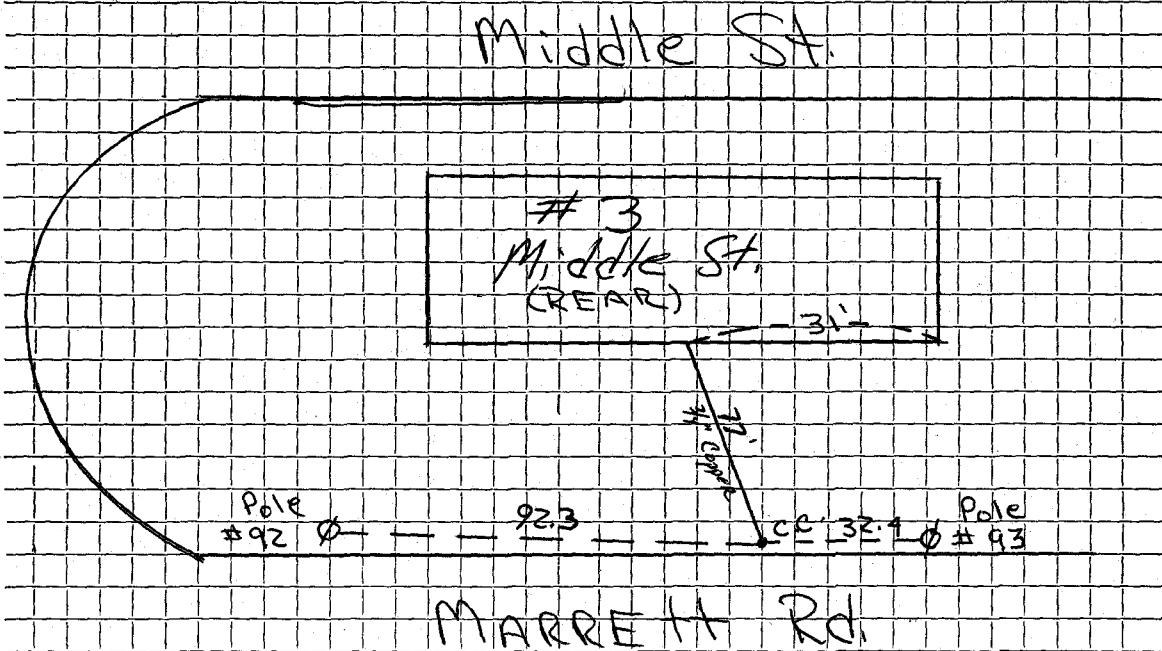

Connection made in Street. Work completed

Remarks:
.....
.....