

## WATER SERVICE RECORD

#5003

Name William Melbye

Service No. 205

Address 30 Middle Street

Location


~~RENEW~~ Renewal ~~NECESSARY~~

Comm 11-30-59

Date	Material	Amount	Total	Date		Amount
9-18-59	Labor	41.25		9-3-59	Deposit	150.00
	10% O.H.	4.13	45.38	11-30-59	Returned	33.44
49'	3/4" Copper tubing@ .41		20.09			111.56
1	3/4" C x 1/2 I.W.H. Stop&Waste		5.84			
3	Hrs. Trucking@ .75		2.25		NON CHARGE	
1	Hr. Trojan Loader@ 3.00		3.00		Labor	22.74
2	Hrs. Town shovel@ 6.50		13.00	27'	3/4" Copper tubing@ .41	11.07
	22 x 3 Patch		<u>22.00</u>	1	3/4" C Corp Cock	5.98
			111.56	1	3/4" C Curb Cock	4.67
				1	Box & Rod	5.00
				1	1/2 Straight tailpiece	.50
				1	1/2 Offset tailpiece	.50
					38 x 6 Patch	<u>76.00</u>
						126.46

TOWN OF LEXINGTON — BOARD OF PUBLIC WORKS  
WATER DIVISION

Sketch of Service Here

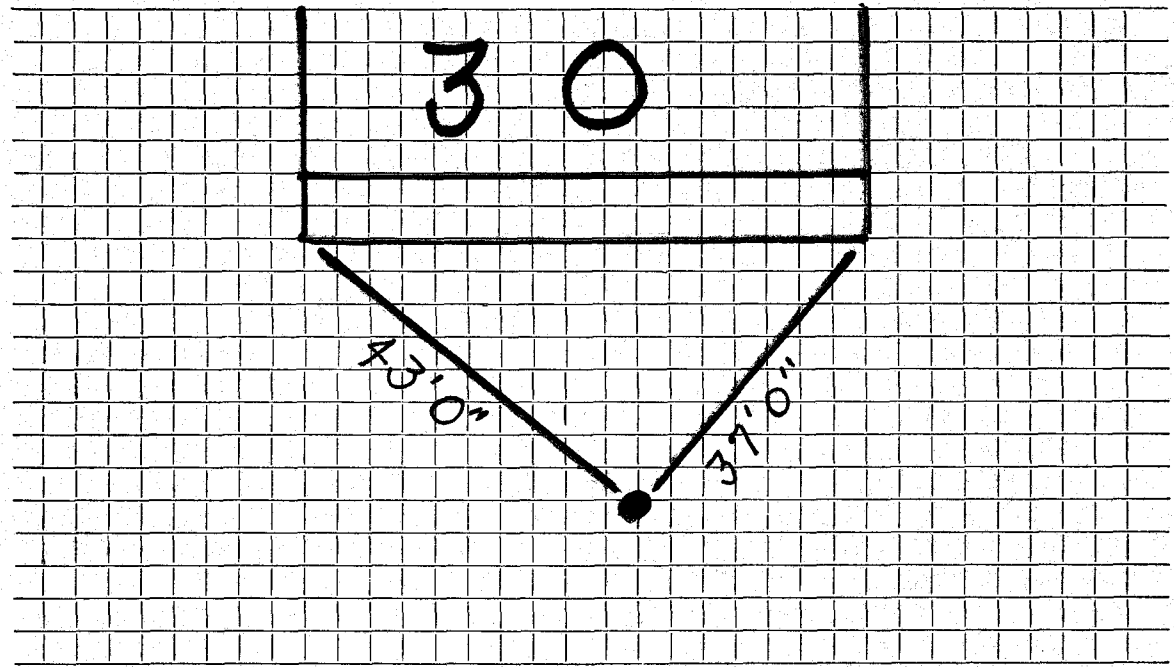

Connection made in ..... Street. Work completed .....

Remarks: *Original Service 7-16-29* .....

.....  
.....